

EAST NORTH STREET RAMP

Area 35,202 Sq. Ft. = 0.81 Acre

AS BUILT SURVEY

FOR

JAMES D. MILLER

GREENVILLE, S.C.

JULY, 1983

FILED
 GREENVILLE, S.C.
 Aug 17 10 32 AM '83
 DONNIE S. FARMERSLEY
 R.M.C.


9-Q-75

AUG 17 1983

5613



W. R. WILLIAMS, JR.
 ENGR. / SURVEYOR, Inc.
 P. E. & L. S. No 3979
 15 S. MAIN STREET
 TRAVELERS REST, S. C.
 29690

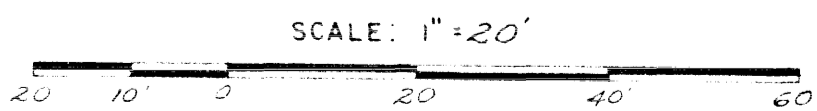

47-2-466



I hereby certify that the ratio of precision of the field survey is 1/4000 as shown hereon and the area was determined by D.M.D. method of area calculation.

W. R. Williams, Jr. P. E. & L. S. No 3979
 AUG 17 1983