


FILED  
GREENVILLE CO. S.C.  
MAY 23 1 49 PM '84  
DUNN & BARKERSLEY  
R.M.C.

FILED  
GREENVILLE CO. S.C.  
MAY 23 1 49 PM '84  
DUNN & BARKERSLEY  
R.M.C.

# AS BUILT SURVEY OF RUTHERFORD PLACE

DEVELOPED BY  
T. WALTER BRASHIER



NEAR TAYLORS, GREENVILLE CO., S.C.

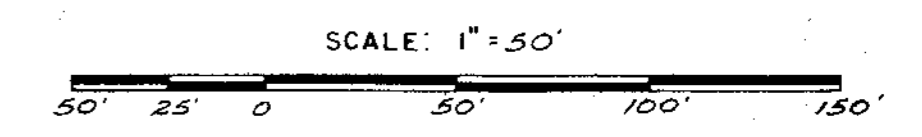

MAY 21, 1984

AREA = 12.40 ACRES  
168 UNITS  
336 PARKING SPACES

LOCATION MAP  
N.T.S.

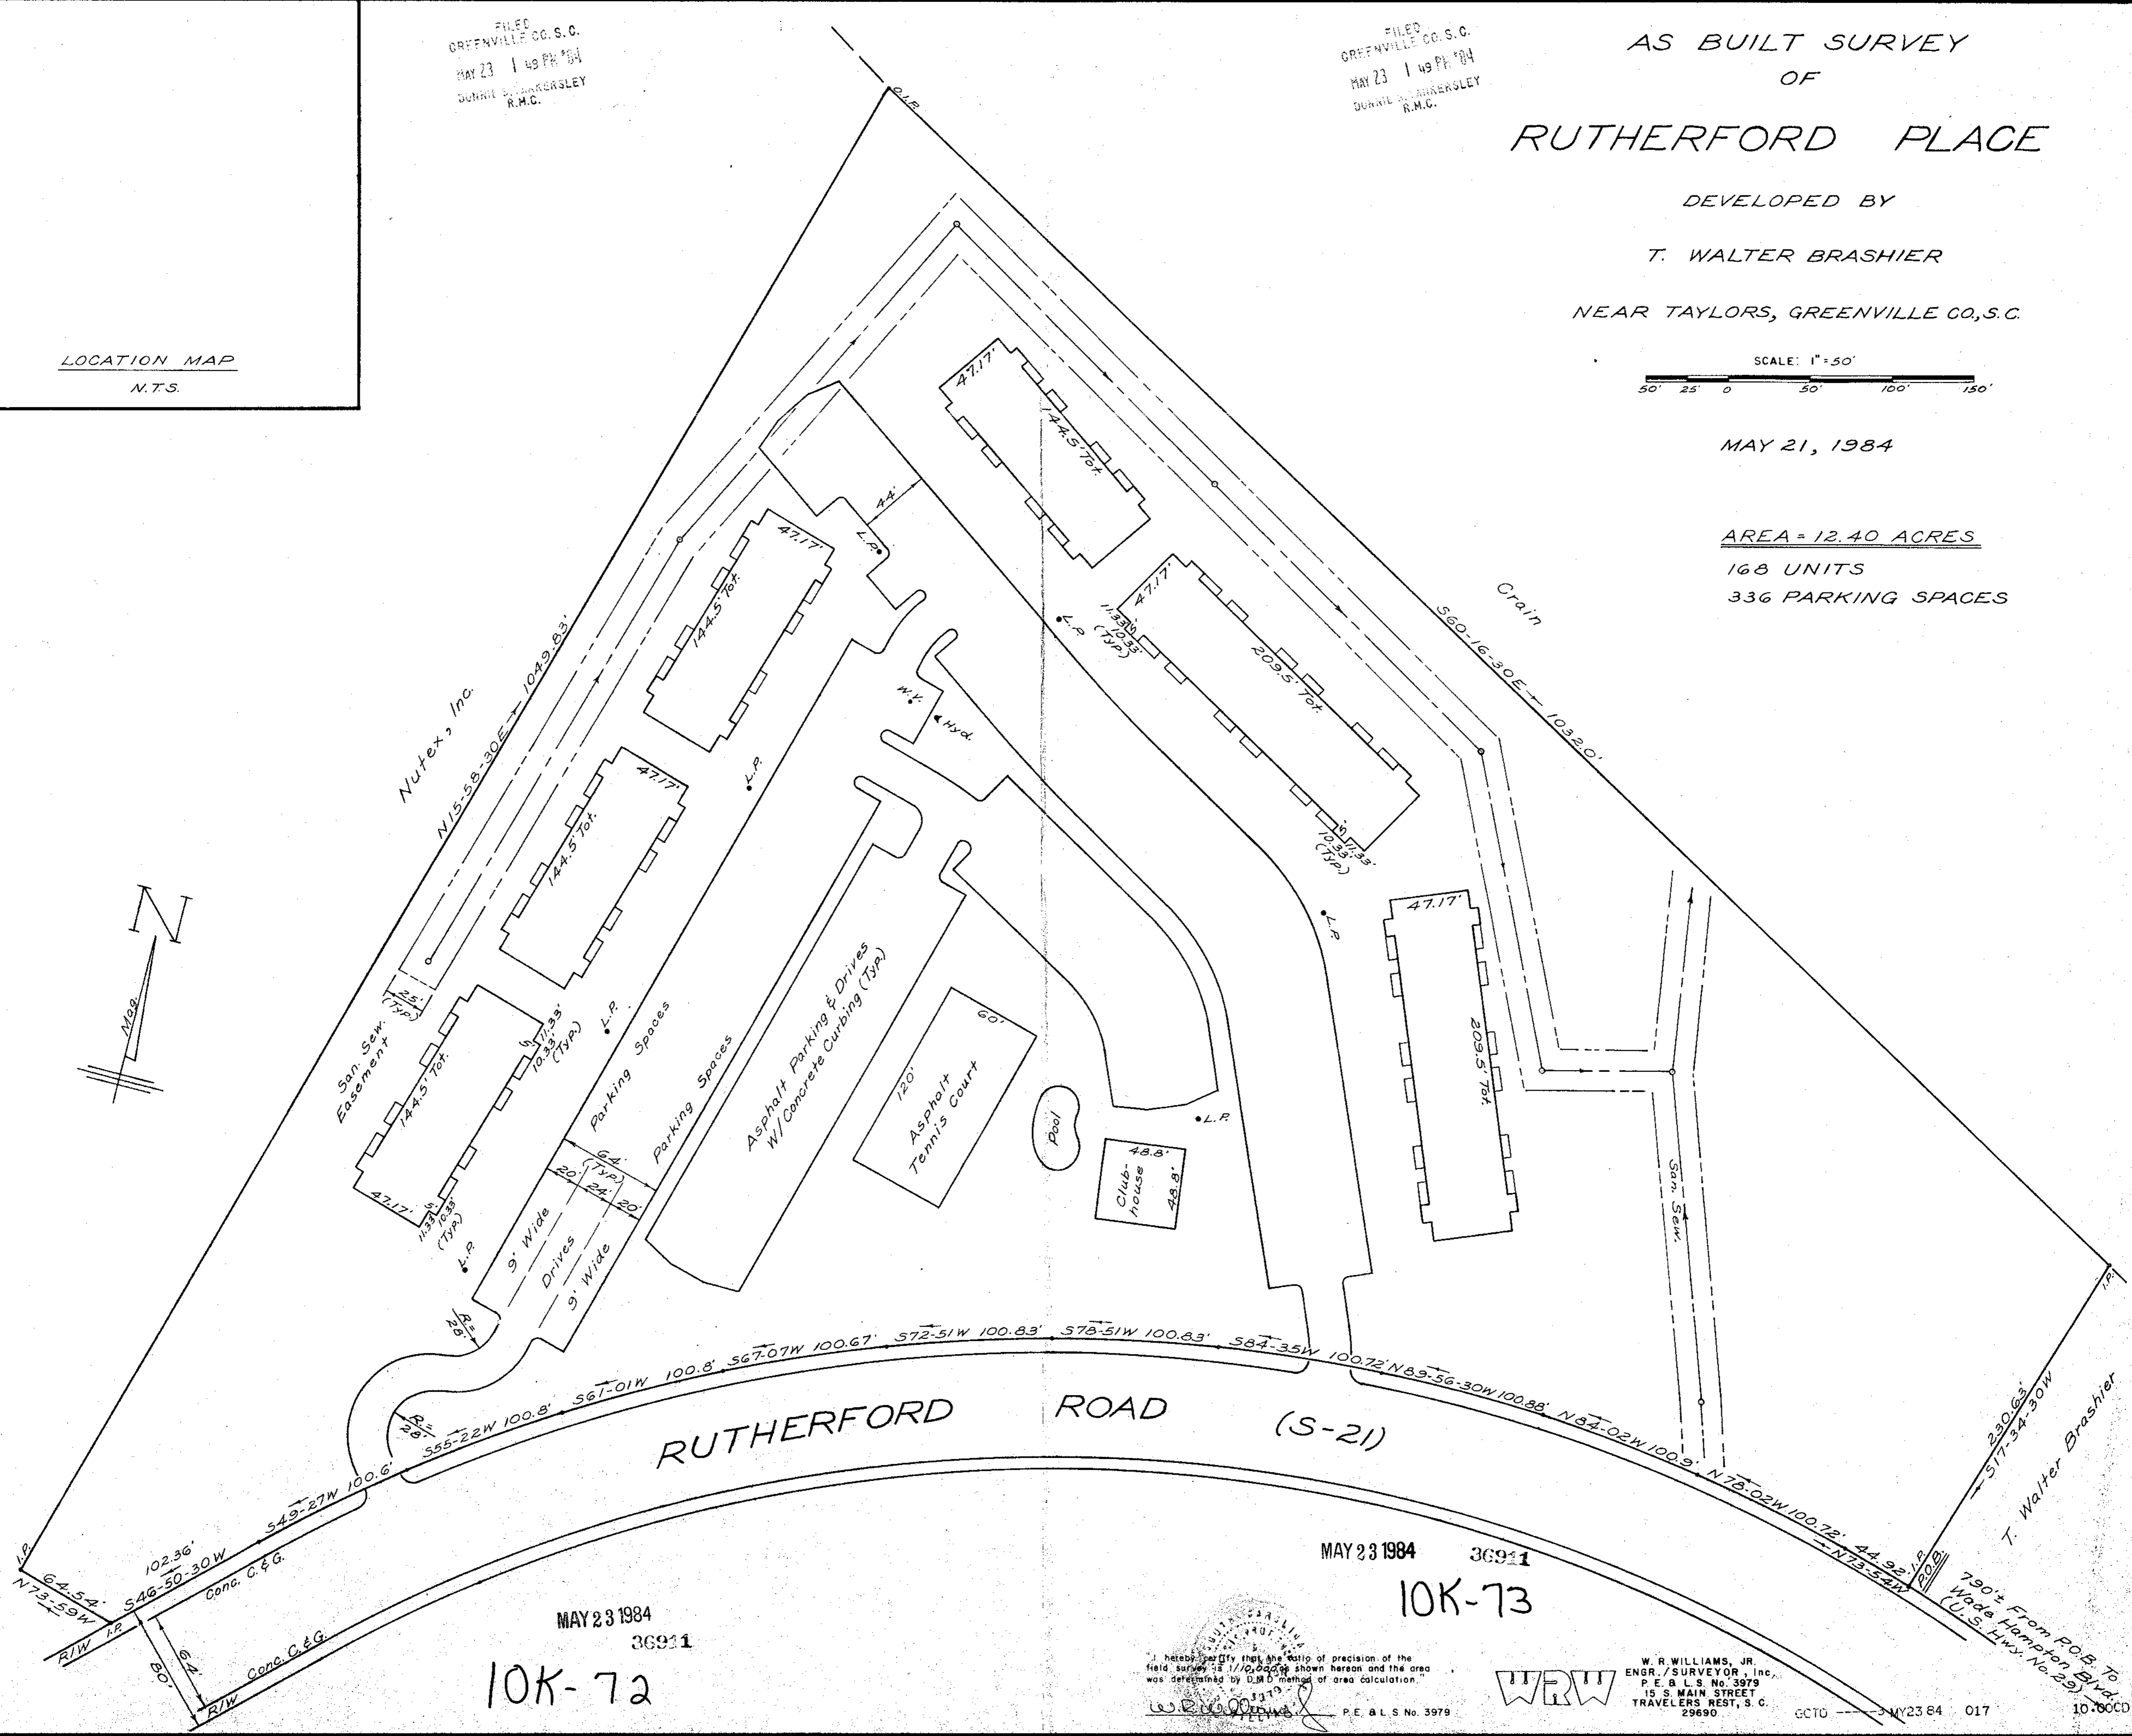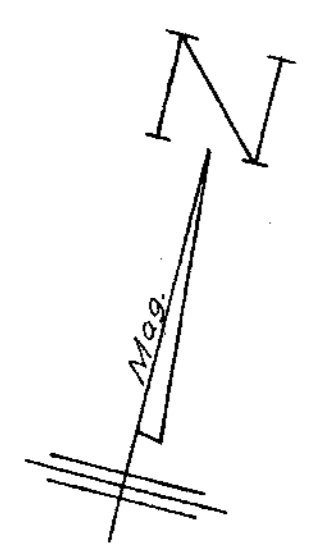

## RUTHERFORD ROAD (S-21)

MAY 23 1984  
36911  
10K-72

MAY 23 1984  
36911  
10K-73

W. R. WILLIAMS, JR.  
ENGR. / SURVEYOR, Inc.  
P. E. & L. S. No. 3979  
15 S. MAIN STREET  
TRAVELERS REST, S. C.  
29690



W. R. WILLIAMS, JR.  
ENGR. / SURVEYOR, Inc.  
P. E. & L. S. No. 3979  
15 S. MAIN STREET  
TRAVELERS REST, S. C.  
29690

GCTD --- MAY 23 84 017

10-0000

T. Walter Brasher  
790 1/2 From P.O. Box To  
Wade Hampton Blvd.  
(U.S. Hwy. No. 29)