


MICROFILMED

FILED
GREENVILLE CO. S.C.

APR 2 12 18 PM '85

DONNIE S. TANKERSLEY
R.M.C.

Bethel Heights Subdivision

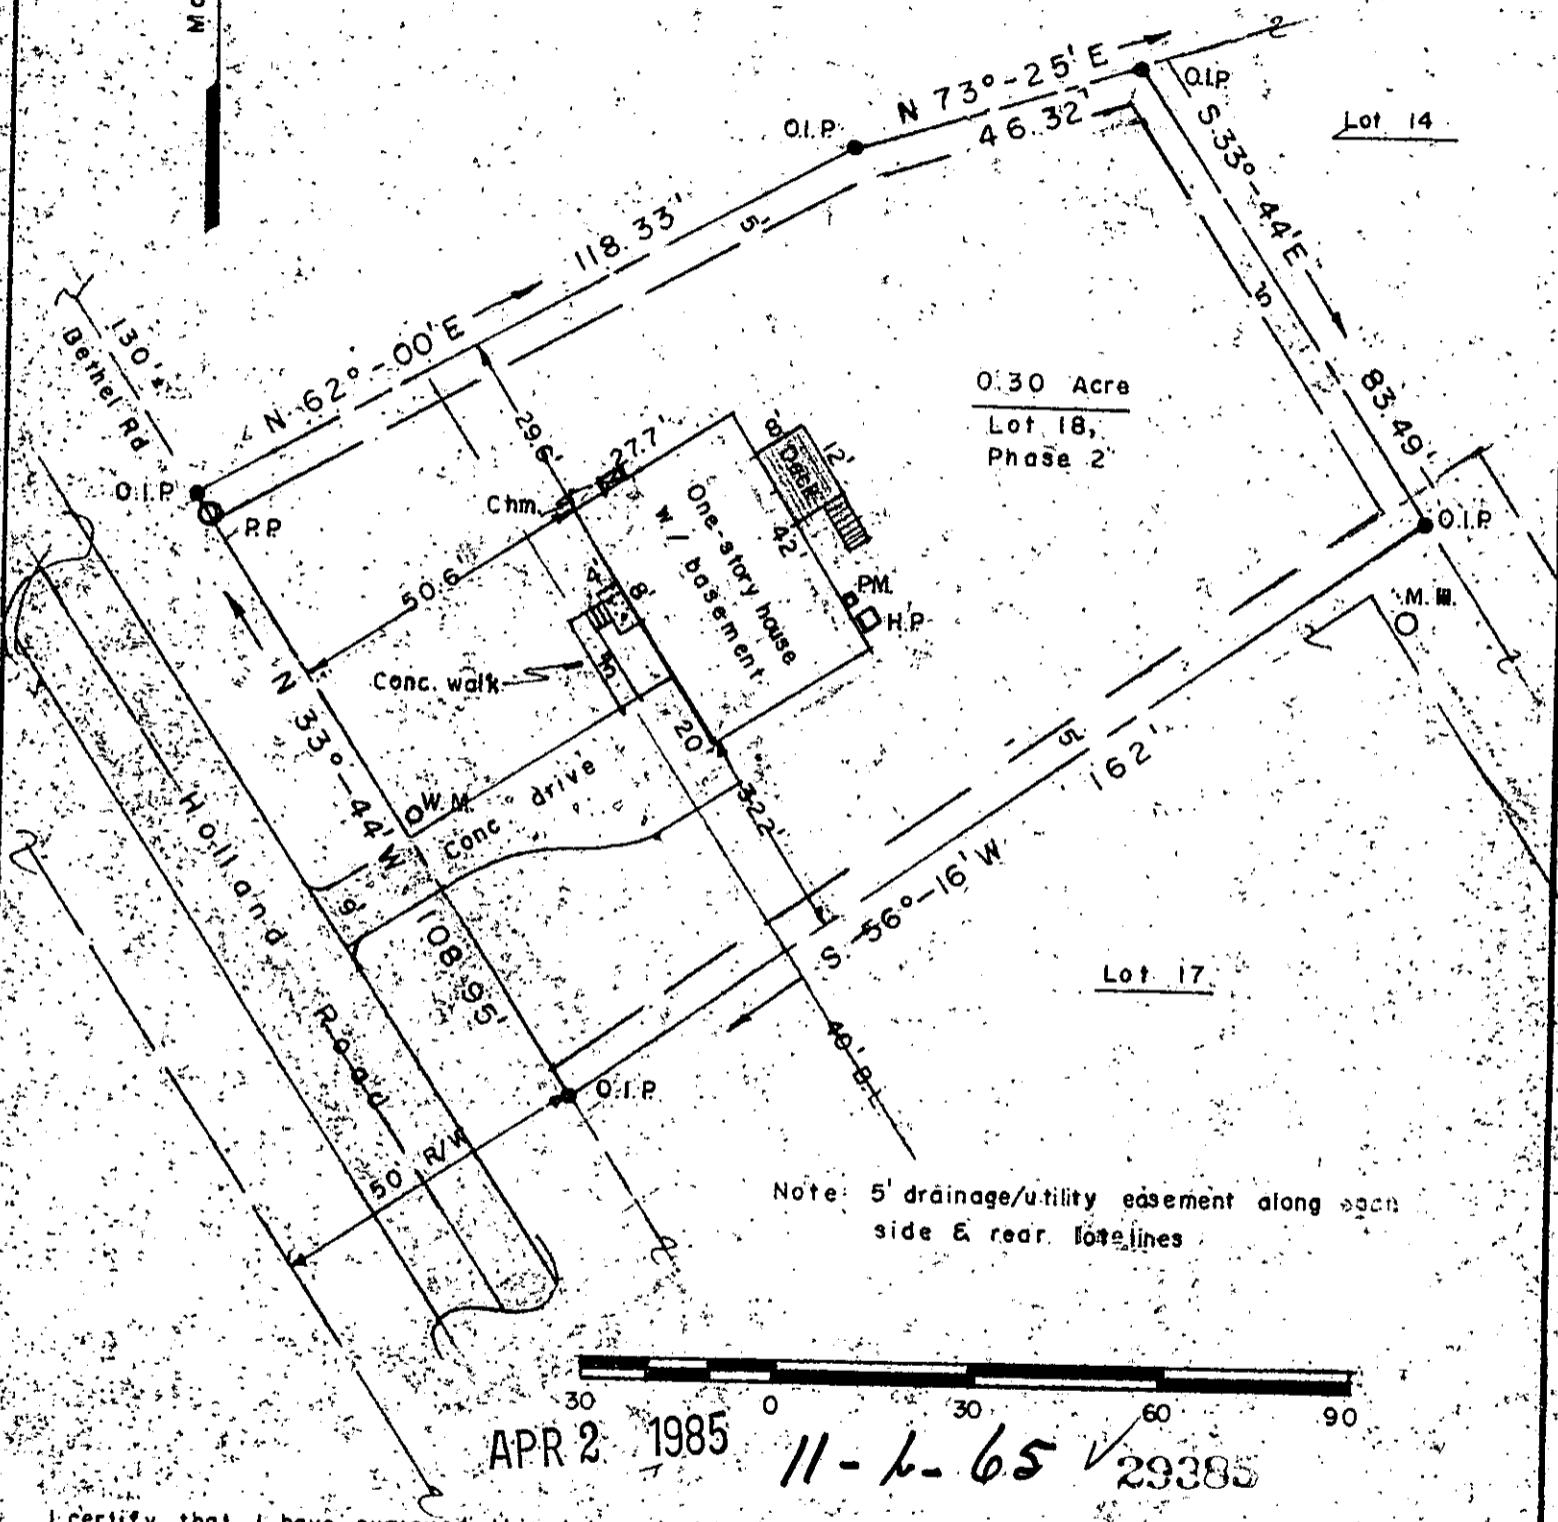

I certify that I have surveyed this lot and that it is, to the best of my knowledge, as shown; that there are no encroachments, unless otherwise shown; and that, unless indicated above, no portion of this lot lies within an officially designated flood plain.

O.I.P.'s at all corners.

All services provided.

Seal

PROPERTY OF
John S. and Melanie K. Wills

Date: 3-21-85

Scale: 1" = 30'

Dwg. No. Final - As Built


Own. By:

Survey References:

Block Sheet:

Plot Bk. 3-066

Deed Vol.

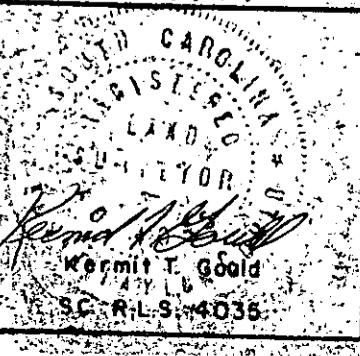

Lot No. 18, "Gilder Creek Estates" Subdivision
Greenville County, Mauldin, South Carolina

K. T. GOULD, INC. AF. 2 85 - 1397
3228-A Wade Hampton Blvd.
Taylors, SC