

SEWER LINE DESCRIPTION

LINE A


EXT. MH	N66-00W	286'
MH A - 1	N42-55W	164'
MH A - 2	N13-35E	71'
MH A - 3	N18-49E (PELHAM RD. CROSSING)	72'
MH A - 4	S71-11E	106'
MH A - 5	S78-11E	159'
MH A - 6		

LINE B

MH A - 4	N59-11W	65'
MH B - 1	N30-49E	342'
MH B - 2	N30-49E	198'
MH B - 3	N30-49E	253'
MH B - 4		

EXISTING SEWER LINE

EXT. MH 2	N61-12'W	224'
EXT. MH 3	N76-12'W	168'
EXT. MH 4	N33-53'W	73'
EXT. MH 5	N38-18'W	254'
EXT. MH 6	N42-47'W	337'
EXT. MH 7	N48-26'W	157'
EXT. MH 8	N66-00'W	

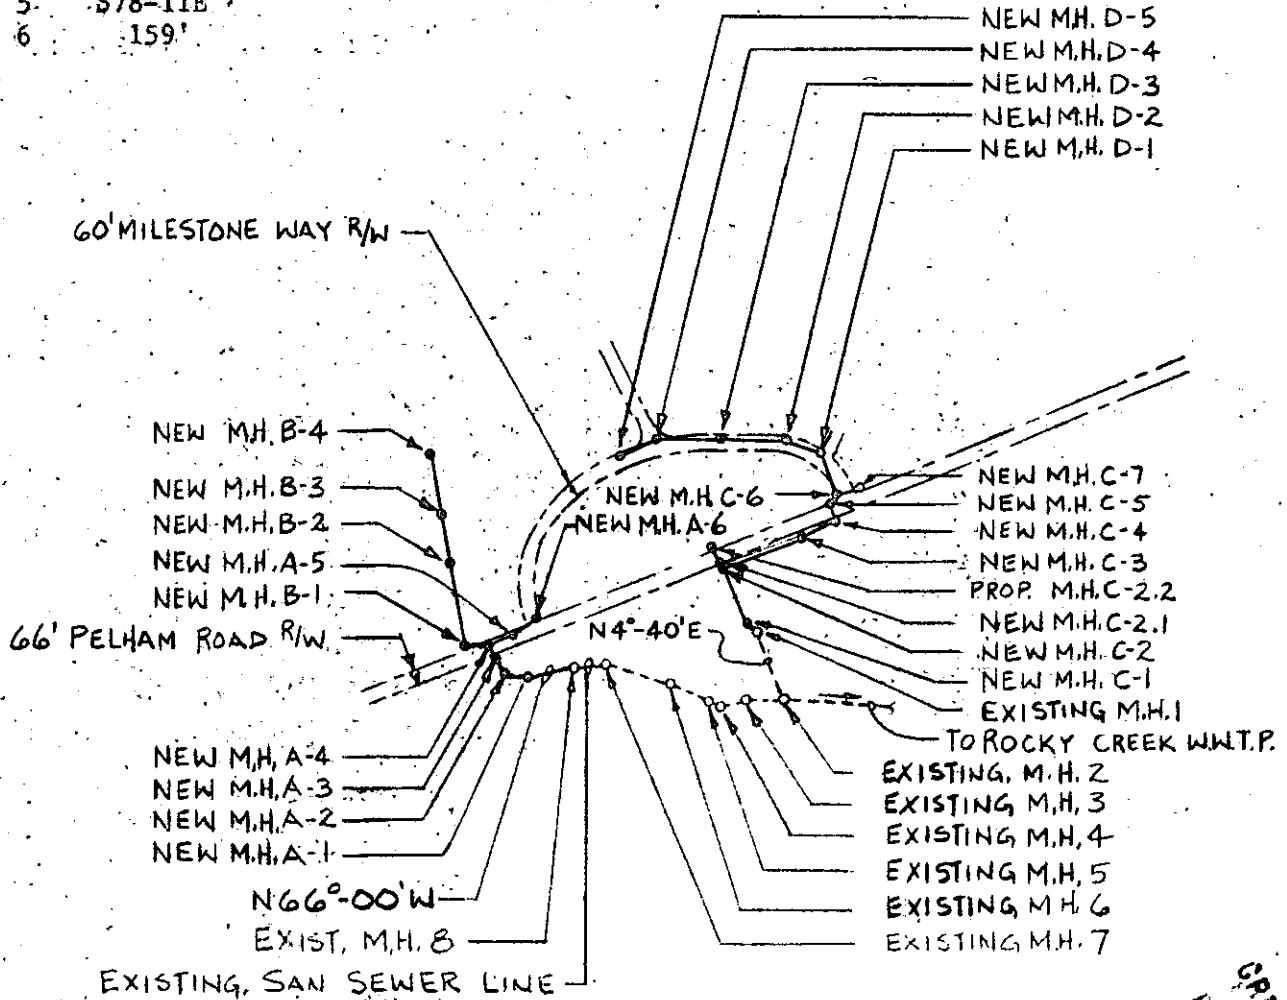

LINE C

EXT. MH	N13-49W	23.0'
MH C - 1	N4-40E	287'
MH C - 2	N2-14W	6'
MH C - 2.1	N2-14W	50'
MH C - 2.2		
MH C - 2	S76-03E	302'
MH C - 3	S82-33E	215'
MH C - 4	N8-09E	61'
MH C - 5	N79-46E	47'
MH C - 6	S71-24E	89'
MHC - 7		

LINE D


MH C - 6	N9-20E	220'
MH D - 1	N41-03W	141'
MH D - 2	N54-29W	294'
MH D - 3	N54-29W	291'
MH D - 4	N41-03W	
MH D - 5	141'	

SCALE: 1"=800'



DEC 23 1985

FILED
GREENVILLE CO. S.C.
DEC 23 11 02 AM 1985
DONNIE S. JANKERSLEY
R.M.C.

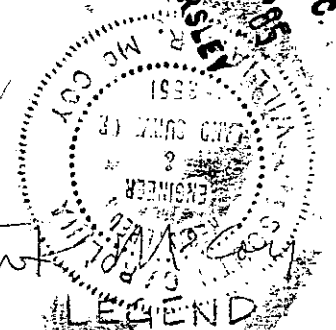

LEGEND

○	EXISTING M.H.
○	NEW M.H.
—	NEW LINE
---	EXISTING LINE
---	ROAD R/W LINE

12 G-13

3	11/1/85	RAS	CORRECTED EXISTING MANHOLES (LOCATIONS, DISTANCES, & BEARINGS)	WRM
2	10/3/85	RAS	ADDED BEARING & DISTANCES	WRM
1	10/1/85	RAS	RECORD DWGS.	WRM
0	9/25/85	RAS	ISSUE TO METRO. SEWER DISTRICT	WRM
REV.	DATE	BY	DESCRIPTION	APP.
REVISION				

SANITARY SEWER FOR
MILESTONE PARK
BY
MILESTONE DEVELOP. CORP.

emwright associates, inc.
engineers planners surveyors
GREENVILLE, SOUTH CAROLINA 29604
925-8815-8000

RAS	RAS	WM
DATE	DATE	DATE
12/23/85	12/23/85	12/23/85