


FILED
GREENVILLE CO. S. C.

AUG 24 12 06 PM 1951

ALLIE FARNSWORTH
R. H. G.

19592
AUG 24 1951

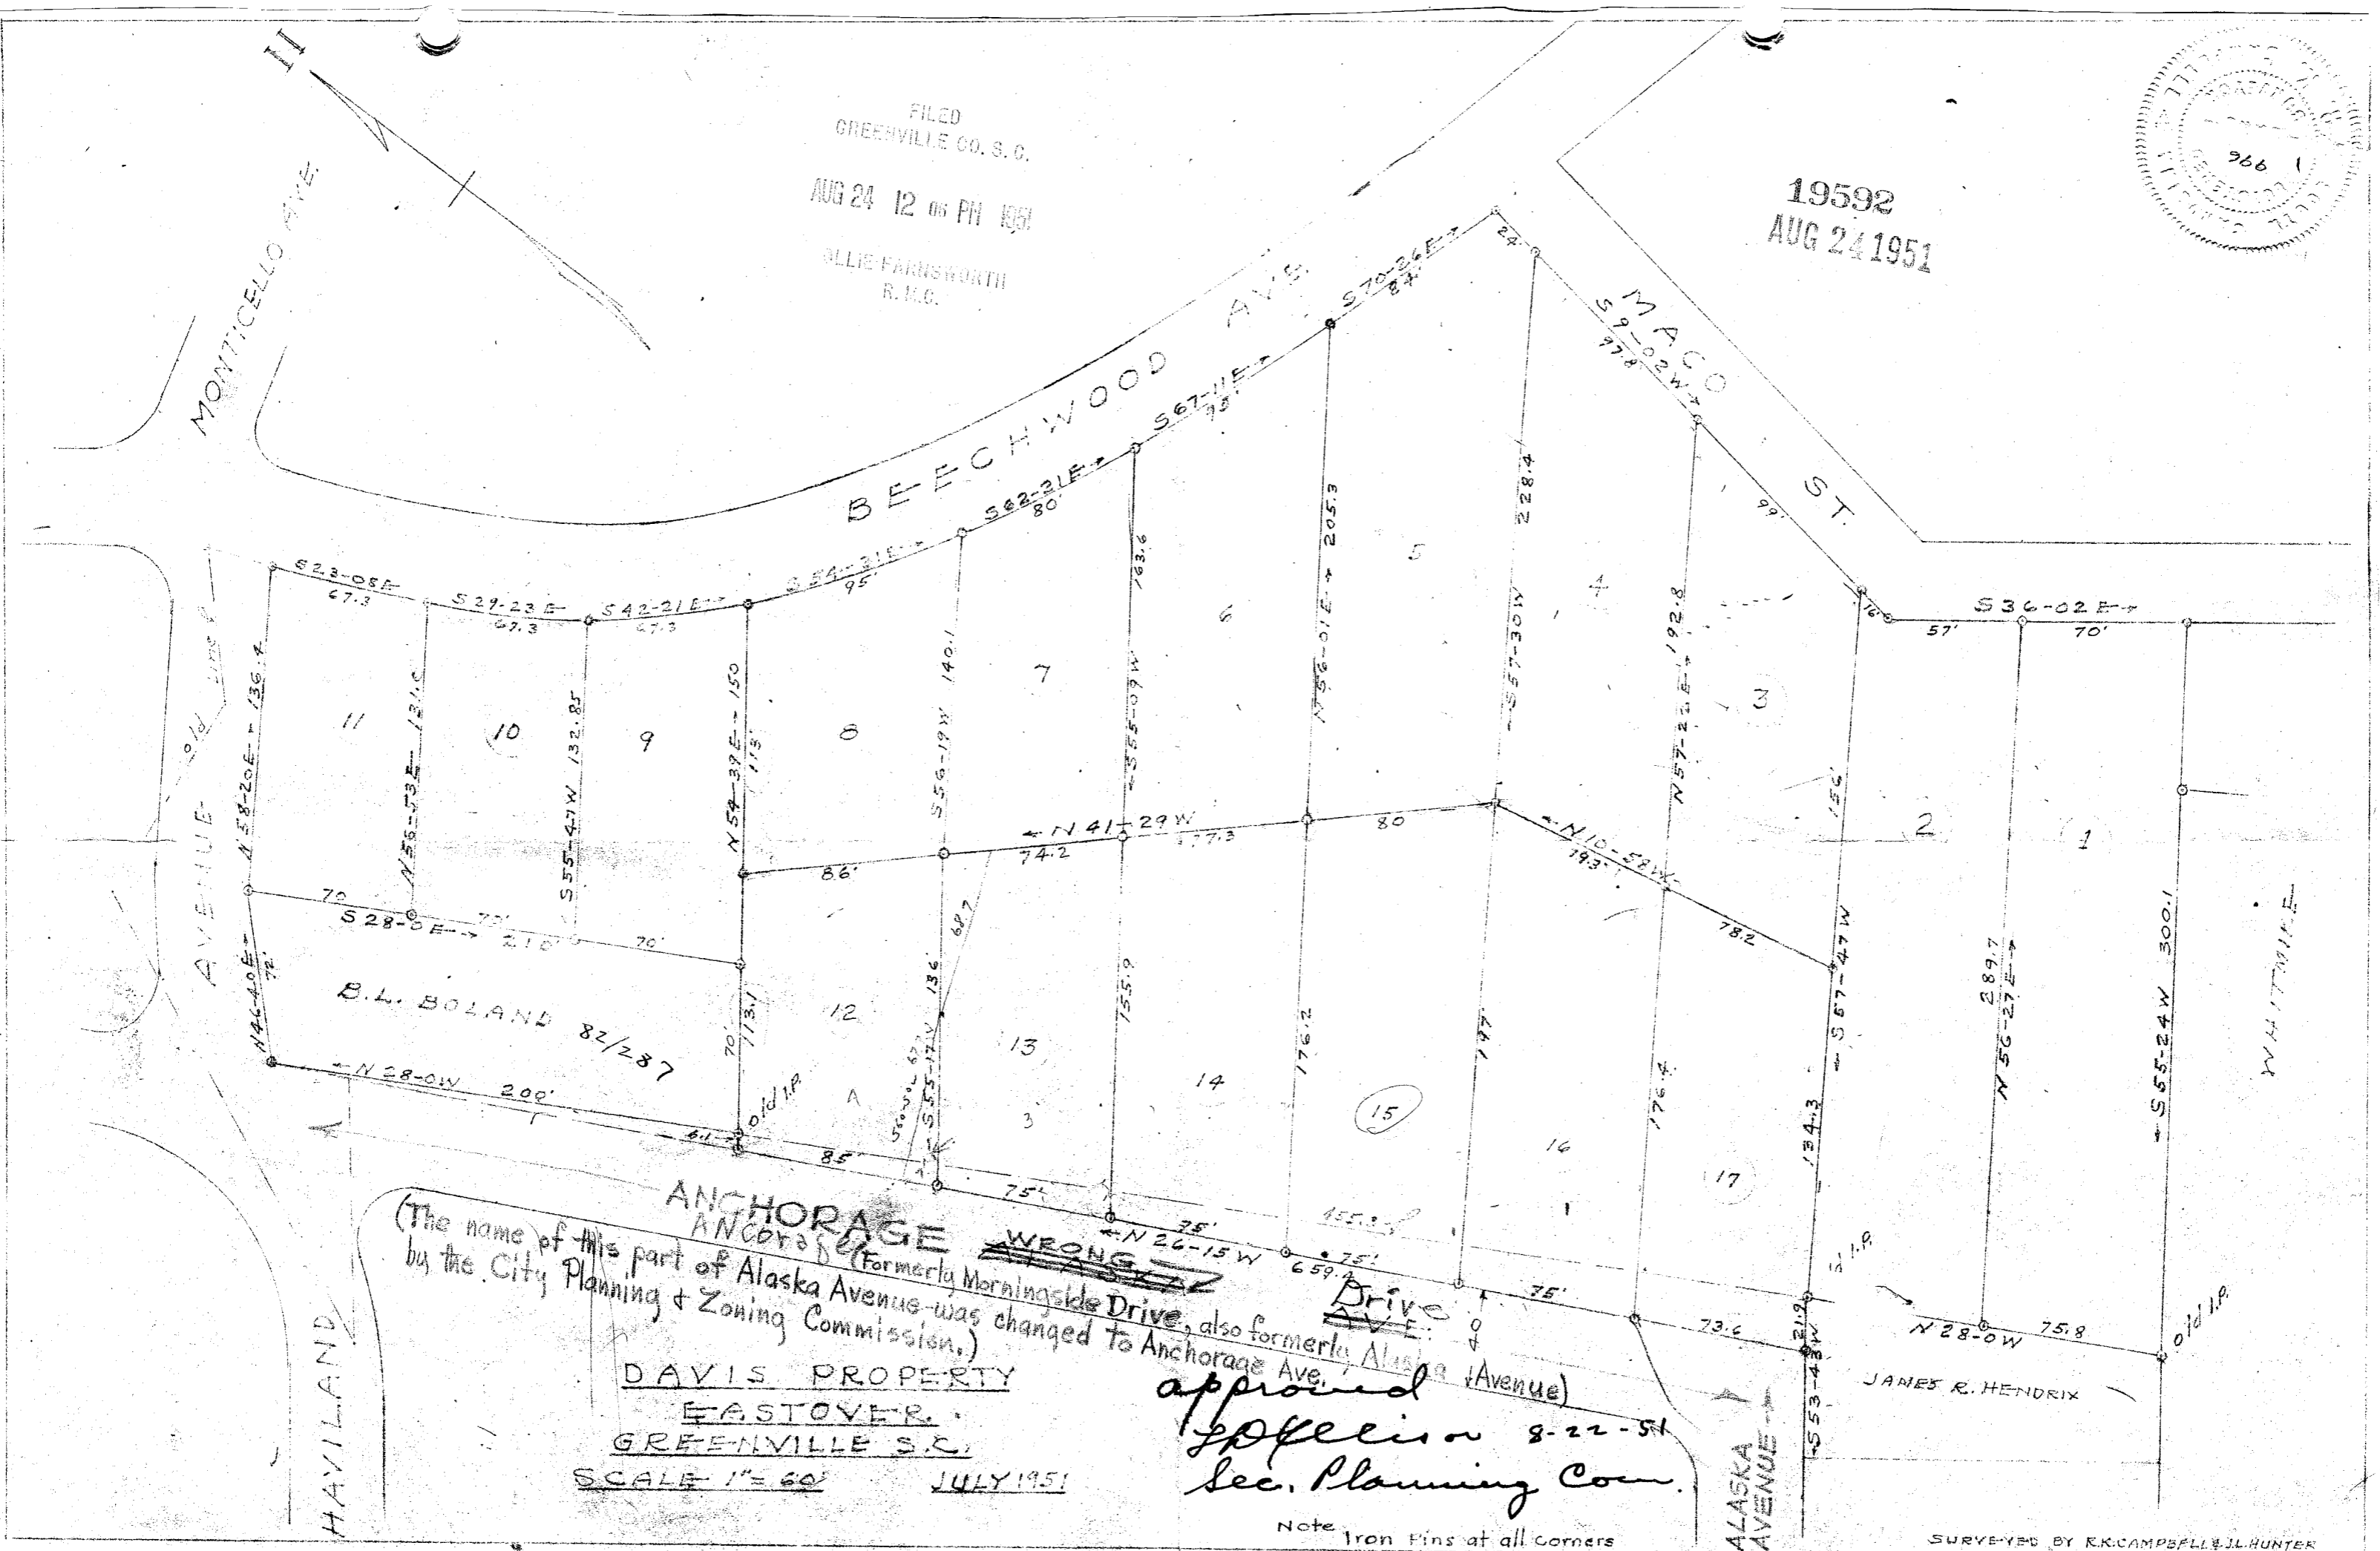

ANCHORAGE
~~ANCHORAGE~~ (The name of this part of Alaska Avenue was changed to Anchorage Ave. by the City Planning & Zoning Commission.)
~~ANCHORAGE~~ (Formerly Morningside Drive, also formerly Alaska Avenue)
DAVIS PROPERTY
EASTOVER
GREENVILLE S.C.
SCALE 1" = 60'
JULY 1951
approved
8-22-51
Sec. Planning Com.

#19592 Filed This 24 day of Aug. 1951
And Recorded in Vol. 77 Page 133 at
Allie Farnsworth
Register Mesne Conveyance Greenville County, S. C.

Part of ...
ALASKA AVENUE

Note Iron Pins at all corners

SURVEYED BY R.K. CAMPBELL & J.L. HUNTER