
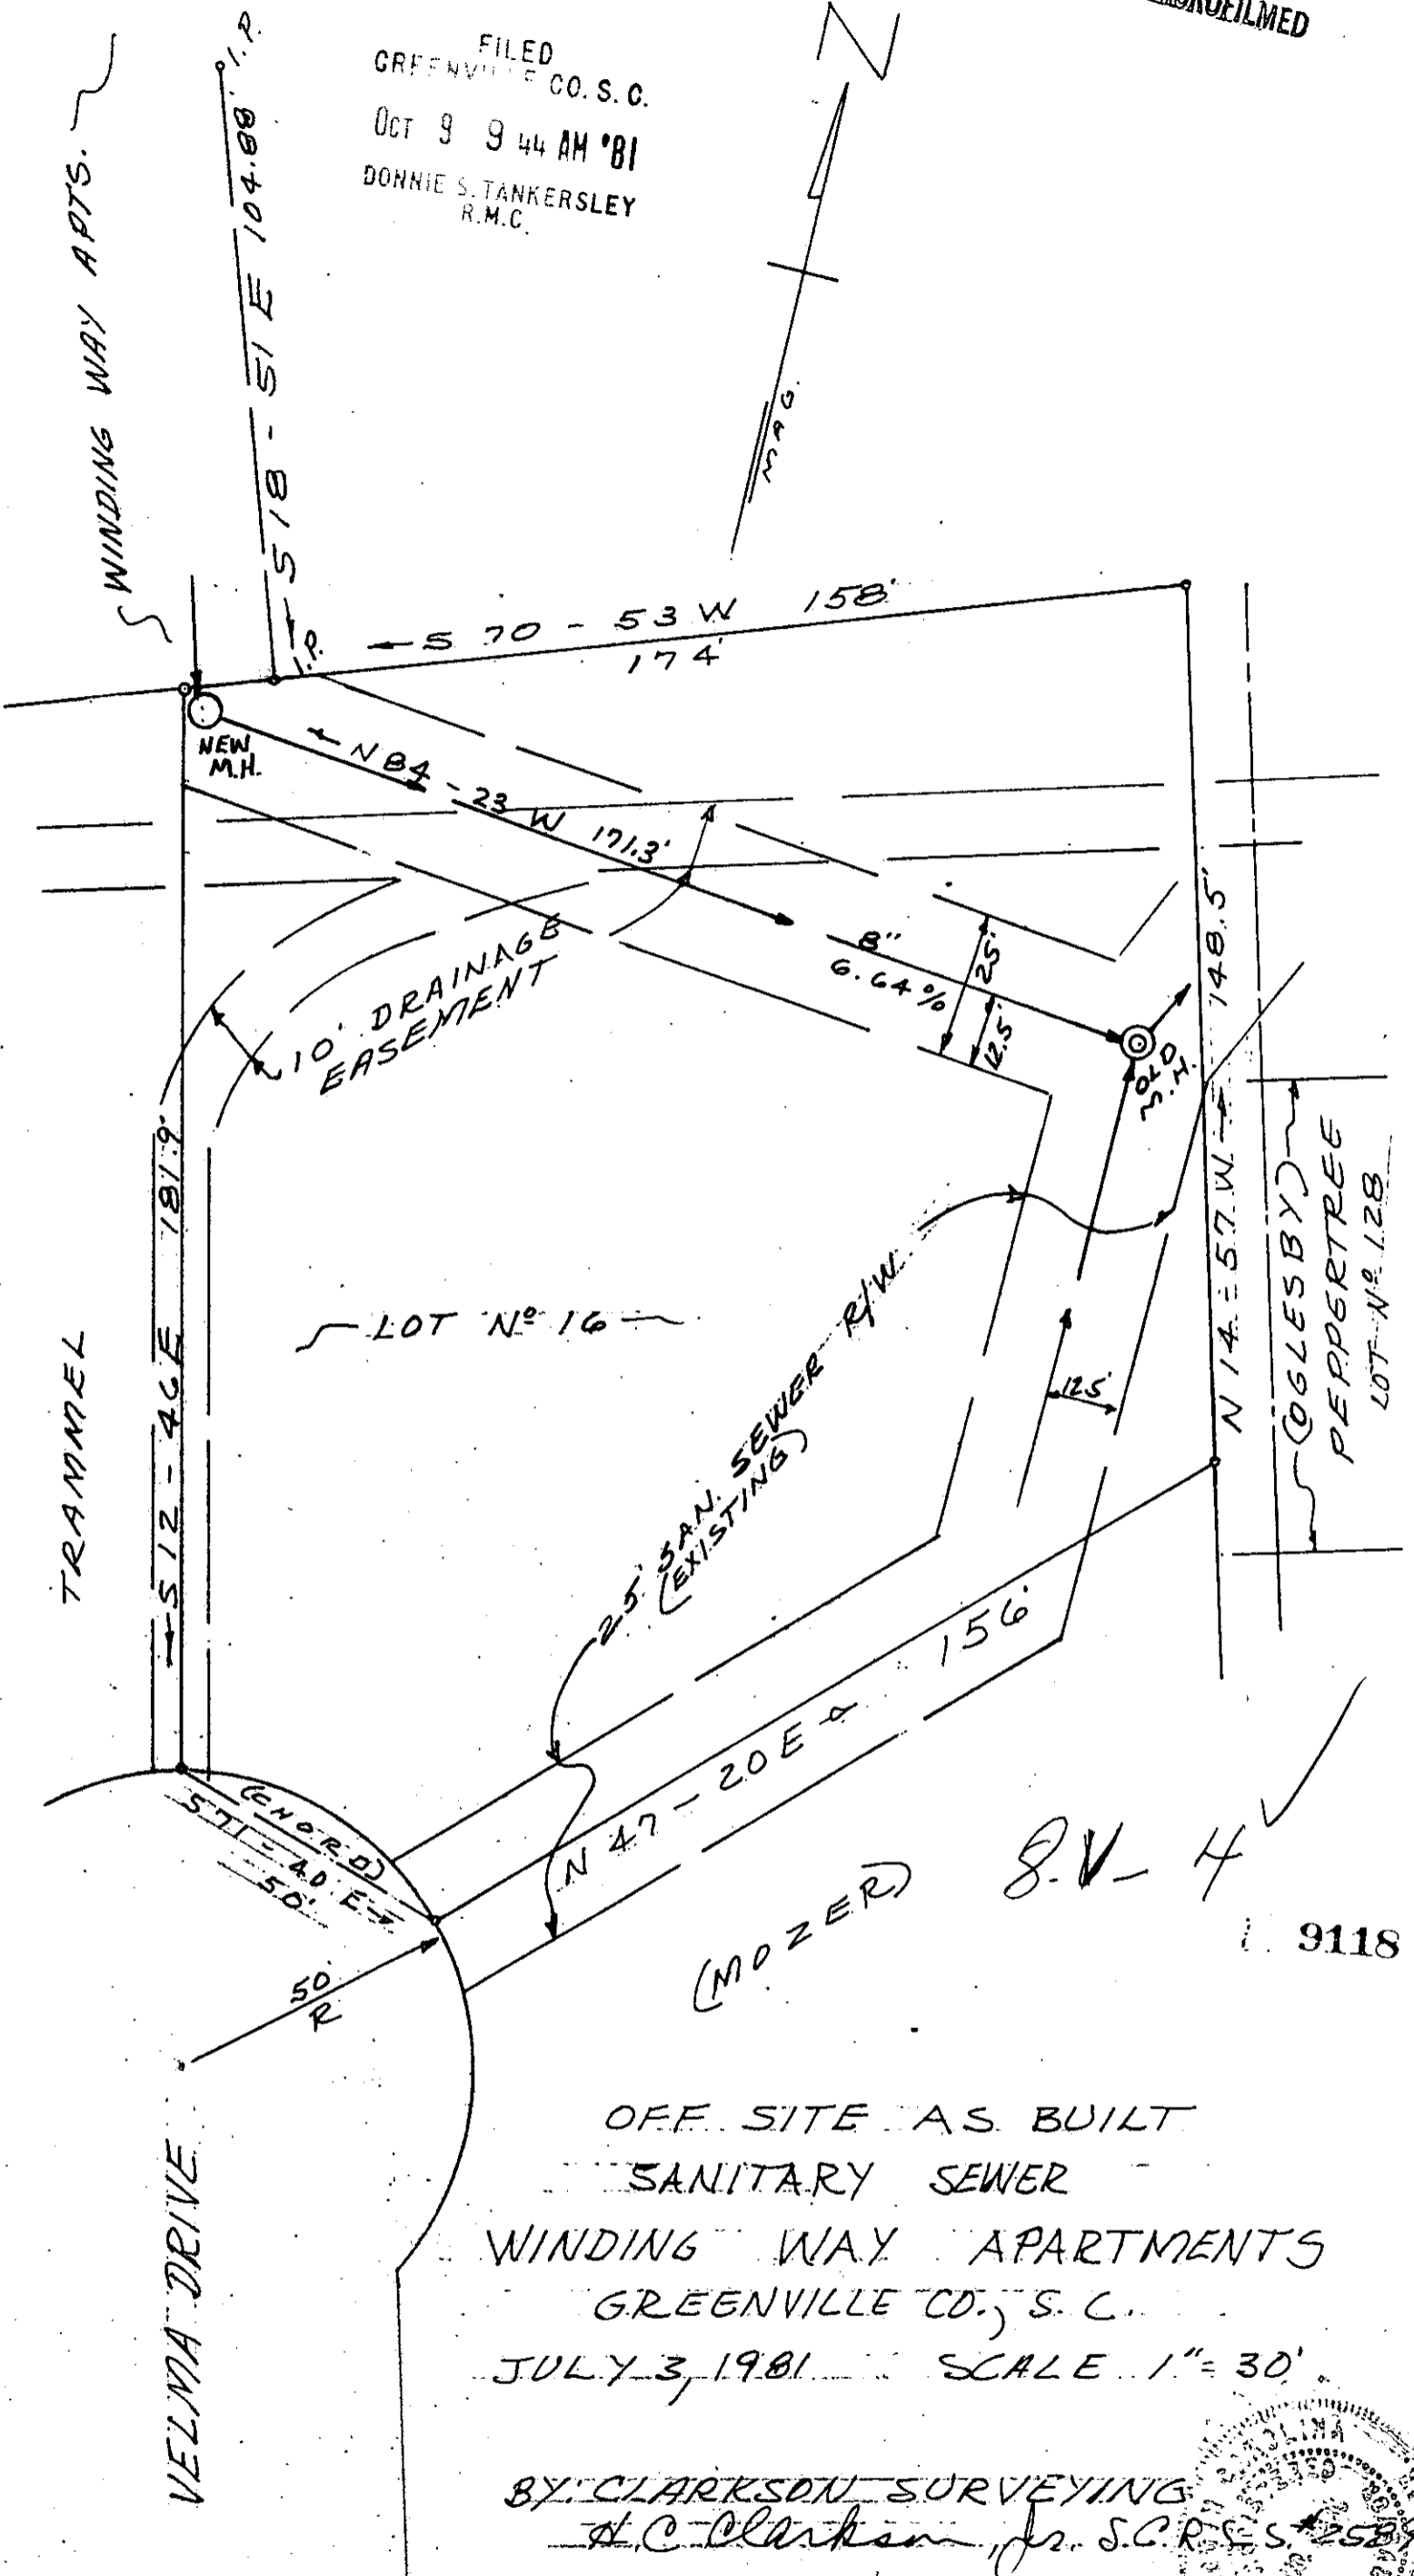


MICROFILMED


FILED
GREENVILLE CO. S.C.
OCT 9 9 44 AM '81
DONNIE S. TANKERSLEY
R.M.C.

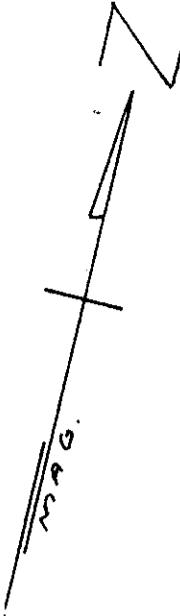

OFF SITE AS BUILT
SANITARY SEWER
WINDING WAY APARTMENTS
GREENVILLE CO., S.C.

JULY 3, 1981 SCALE 1" = 30'

BY CLARKSON SURVEYING
H.C. Clarkson, Jr. S.C.R.E.S. #258

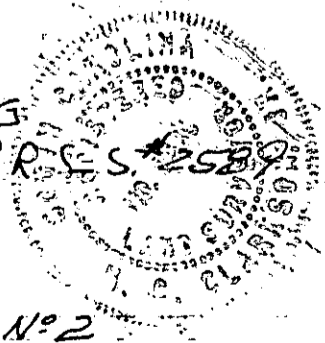

RE: LOT NO. 16 = TAYLOR HEIGHTS - GVILLE RMC - PLAT BOOK 4X - PAGE NO. 2
DEED BOOK 1132 - PAGE 767

NOTE: BEARINGS ON THIS DRAWING CONVERTED TO SAME MAGNETIC DATUM AS WINDING WAY APARTMENTS SURVEY SO THAT COMMON LINES AGREE ON BEARING CALLS - THIS DOES NOT ALTER THE LOCATION OR CORNERS OF LOT NO. 16.