



MICROFILMED

FILED  
GREENVILLE S.C.  
JUN 7 9 56 AM '82  
DORRIS TANKERSLEY  
R.M.C.

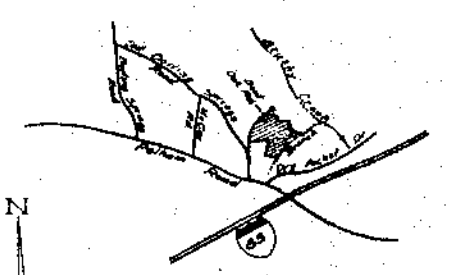


LOCATION MAP  
NOT TO SCALE

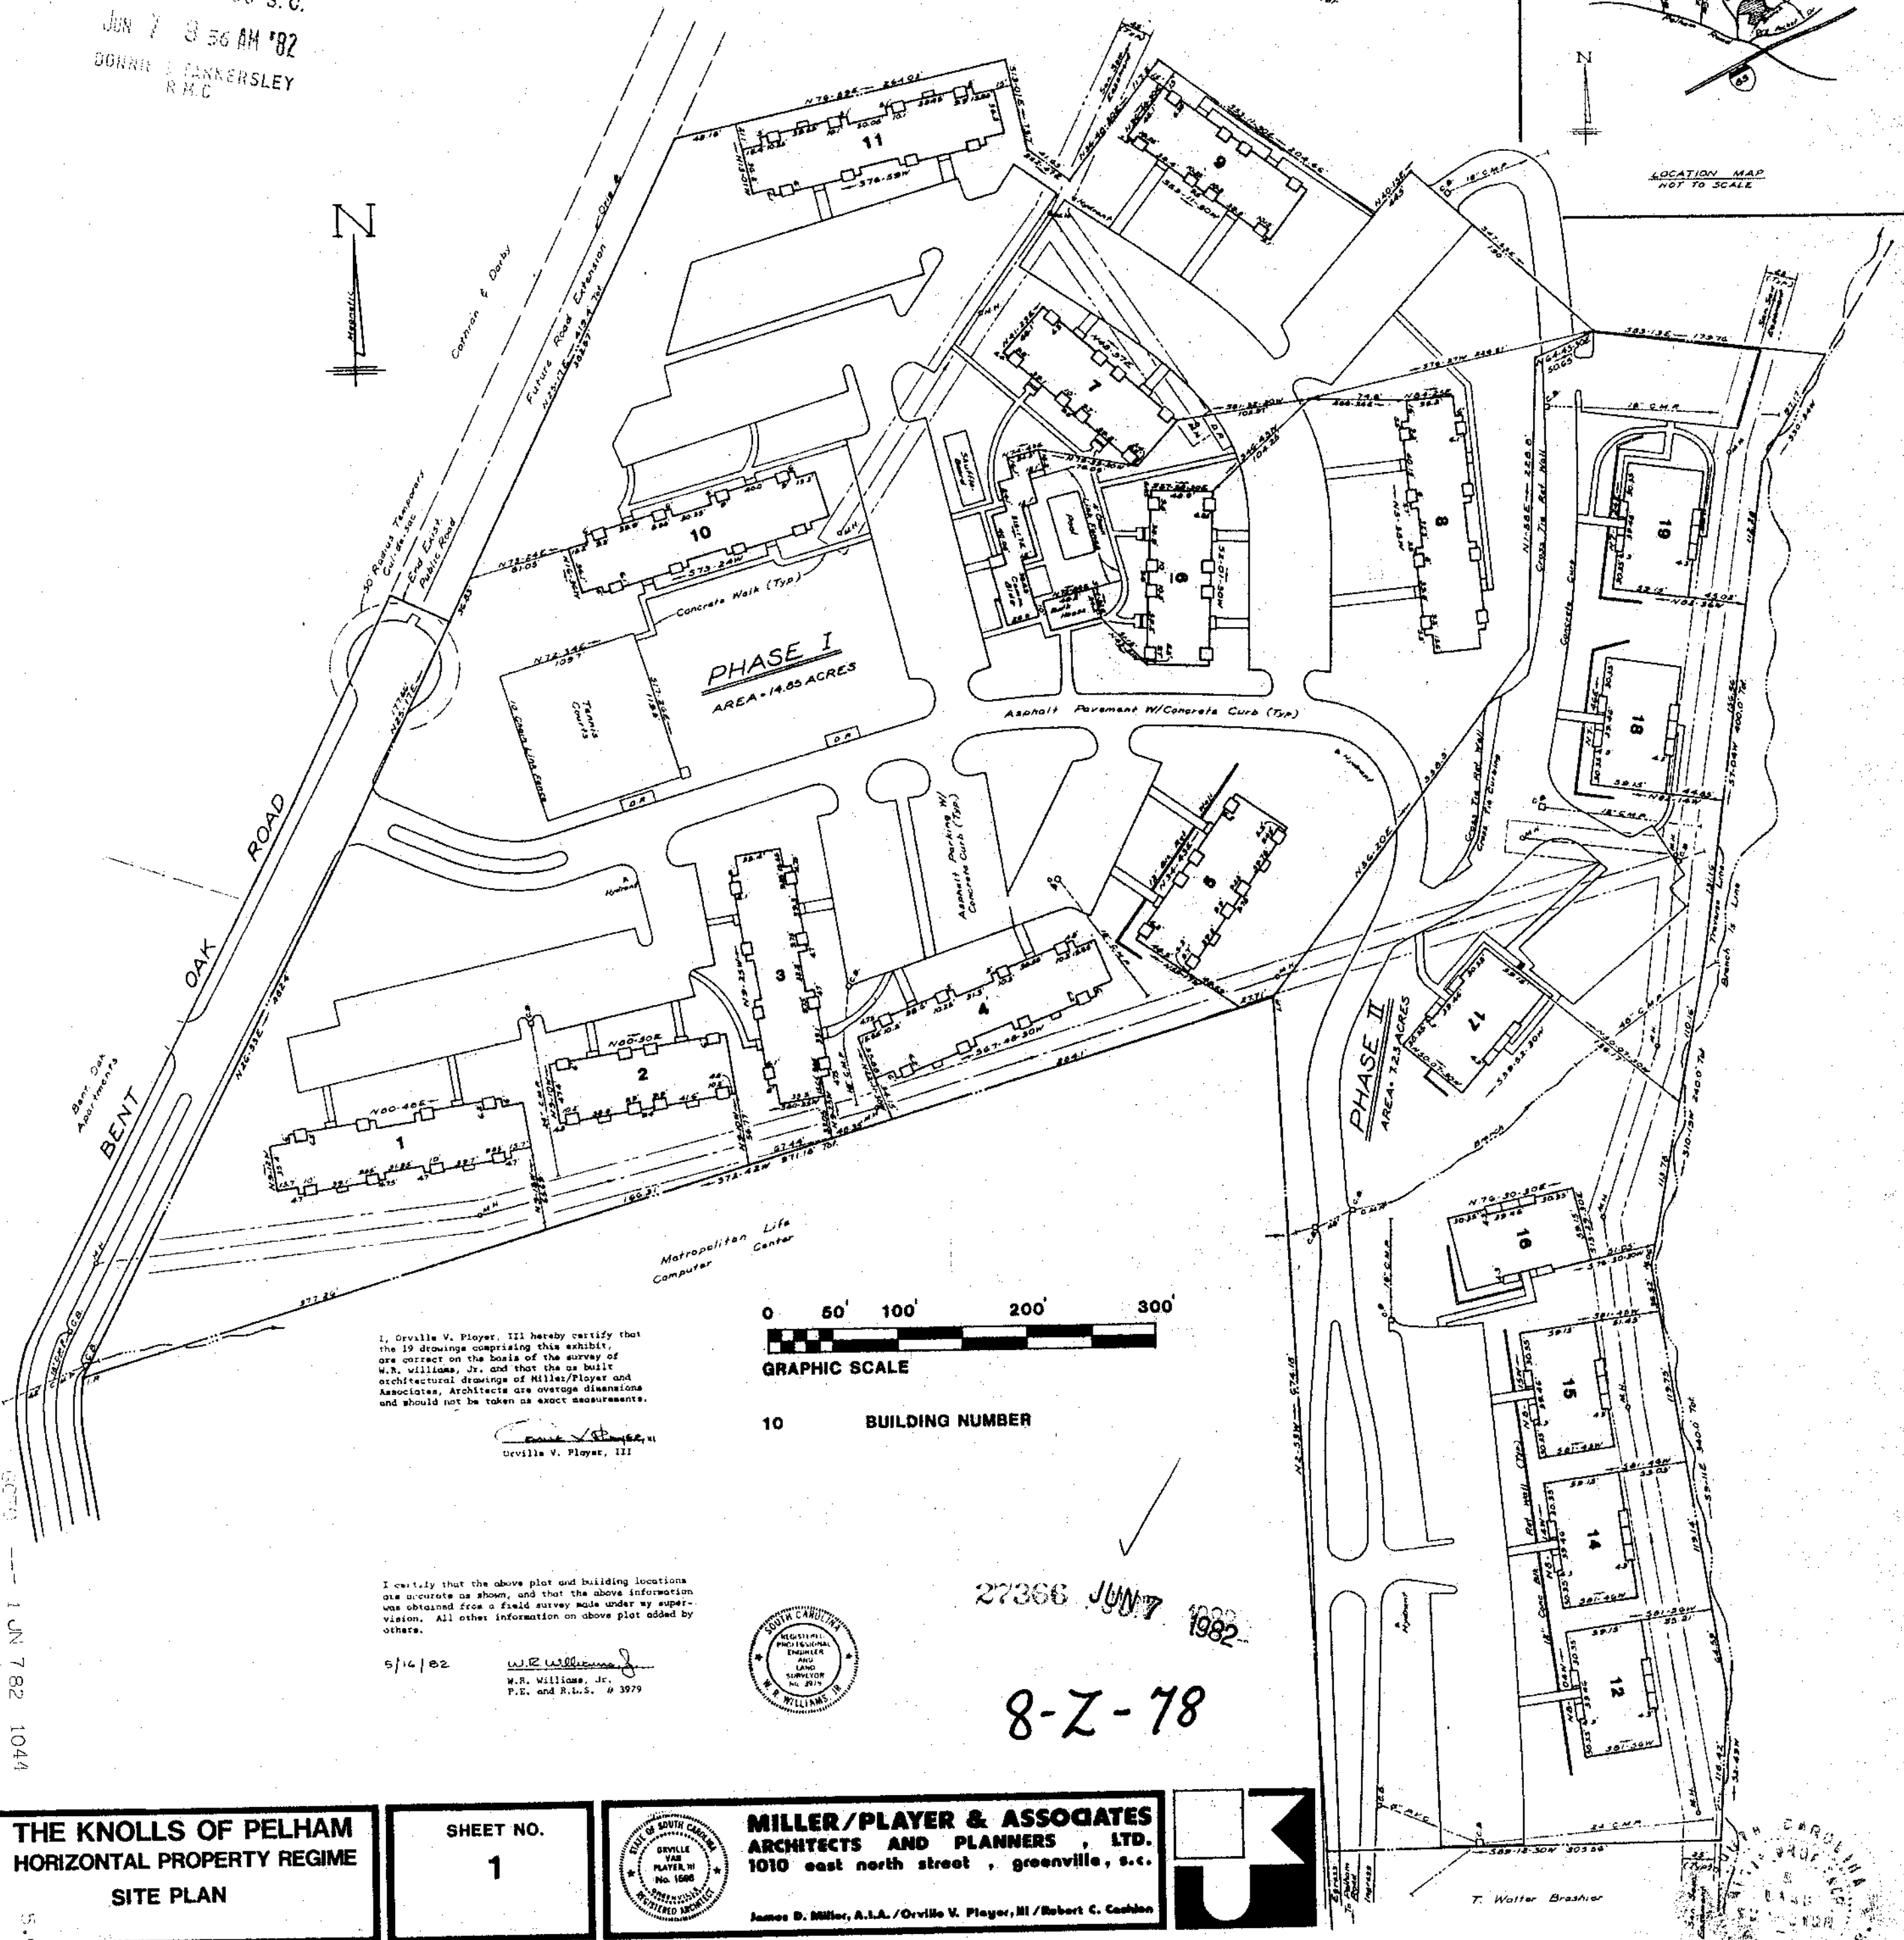

I, Orville V. Ployer, III hereby certify that the 19 drawings comprising this exhibit, are correct on the basis of the survey of W.R. Williams, Jr. and that the as built architectural drawings of Miller/Player and Associates, Architects are overage dimensions and should not be taken as exact measurements.

Orville V. Ployer, III

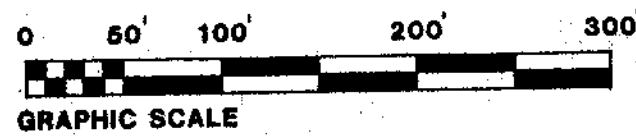

GRAPHIC SCALE  
10 BUILDING NUMBER

I certify that the above plot and building locations are accurate as shown, and that the above information was obtained from a field survey made under my supervision. All other information on above plot added by others.

5/14/82  
W.R. Williams, Jr.  
P.E. and R.L.S. # 3979



27366 JUN 7 1982

8-2-78

THE KNOLLS OF PELHAM  
HORIZONTAL PROPERTY REGIME  
SITE PLAN

SHEET NO.  
1



MILLER/PLAYER & ASSOCIATES  
ARCHITECTS AND PLANNERS, LTD.  
1010 east north street, greenville, s.c.

James B. Miller, A.L.A. / Orville V. Ployer, III / Robert C. Cashin



3. Miller/Player & Associates, Architects and Planners, Ltd. is a professional corporation organized under the laws of the State of South Carolina. It is a member of the South Carolina Association of Professional Engineers and Land Surveyors. It is a member of the South Carolina Association of Architects and Planners. It is a member of the South Carolina Association of Professional Engineers and Land Surveyors. It is a member of the South Carolina Association of Architects and Planners.

1 JUN 7 82 1044

5.0001