
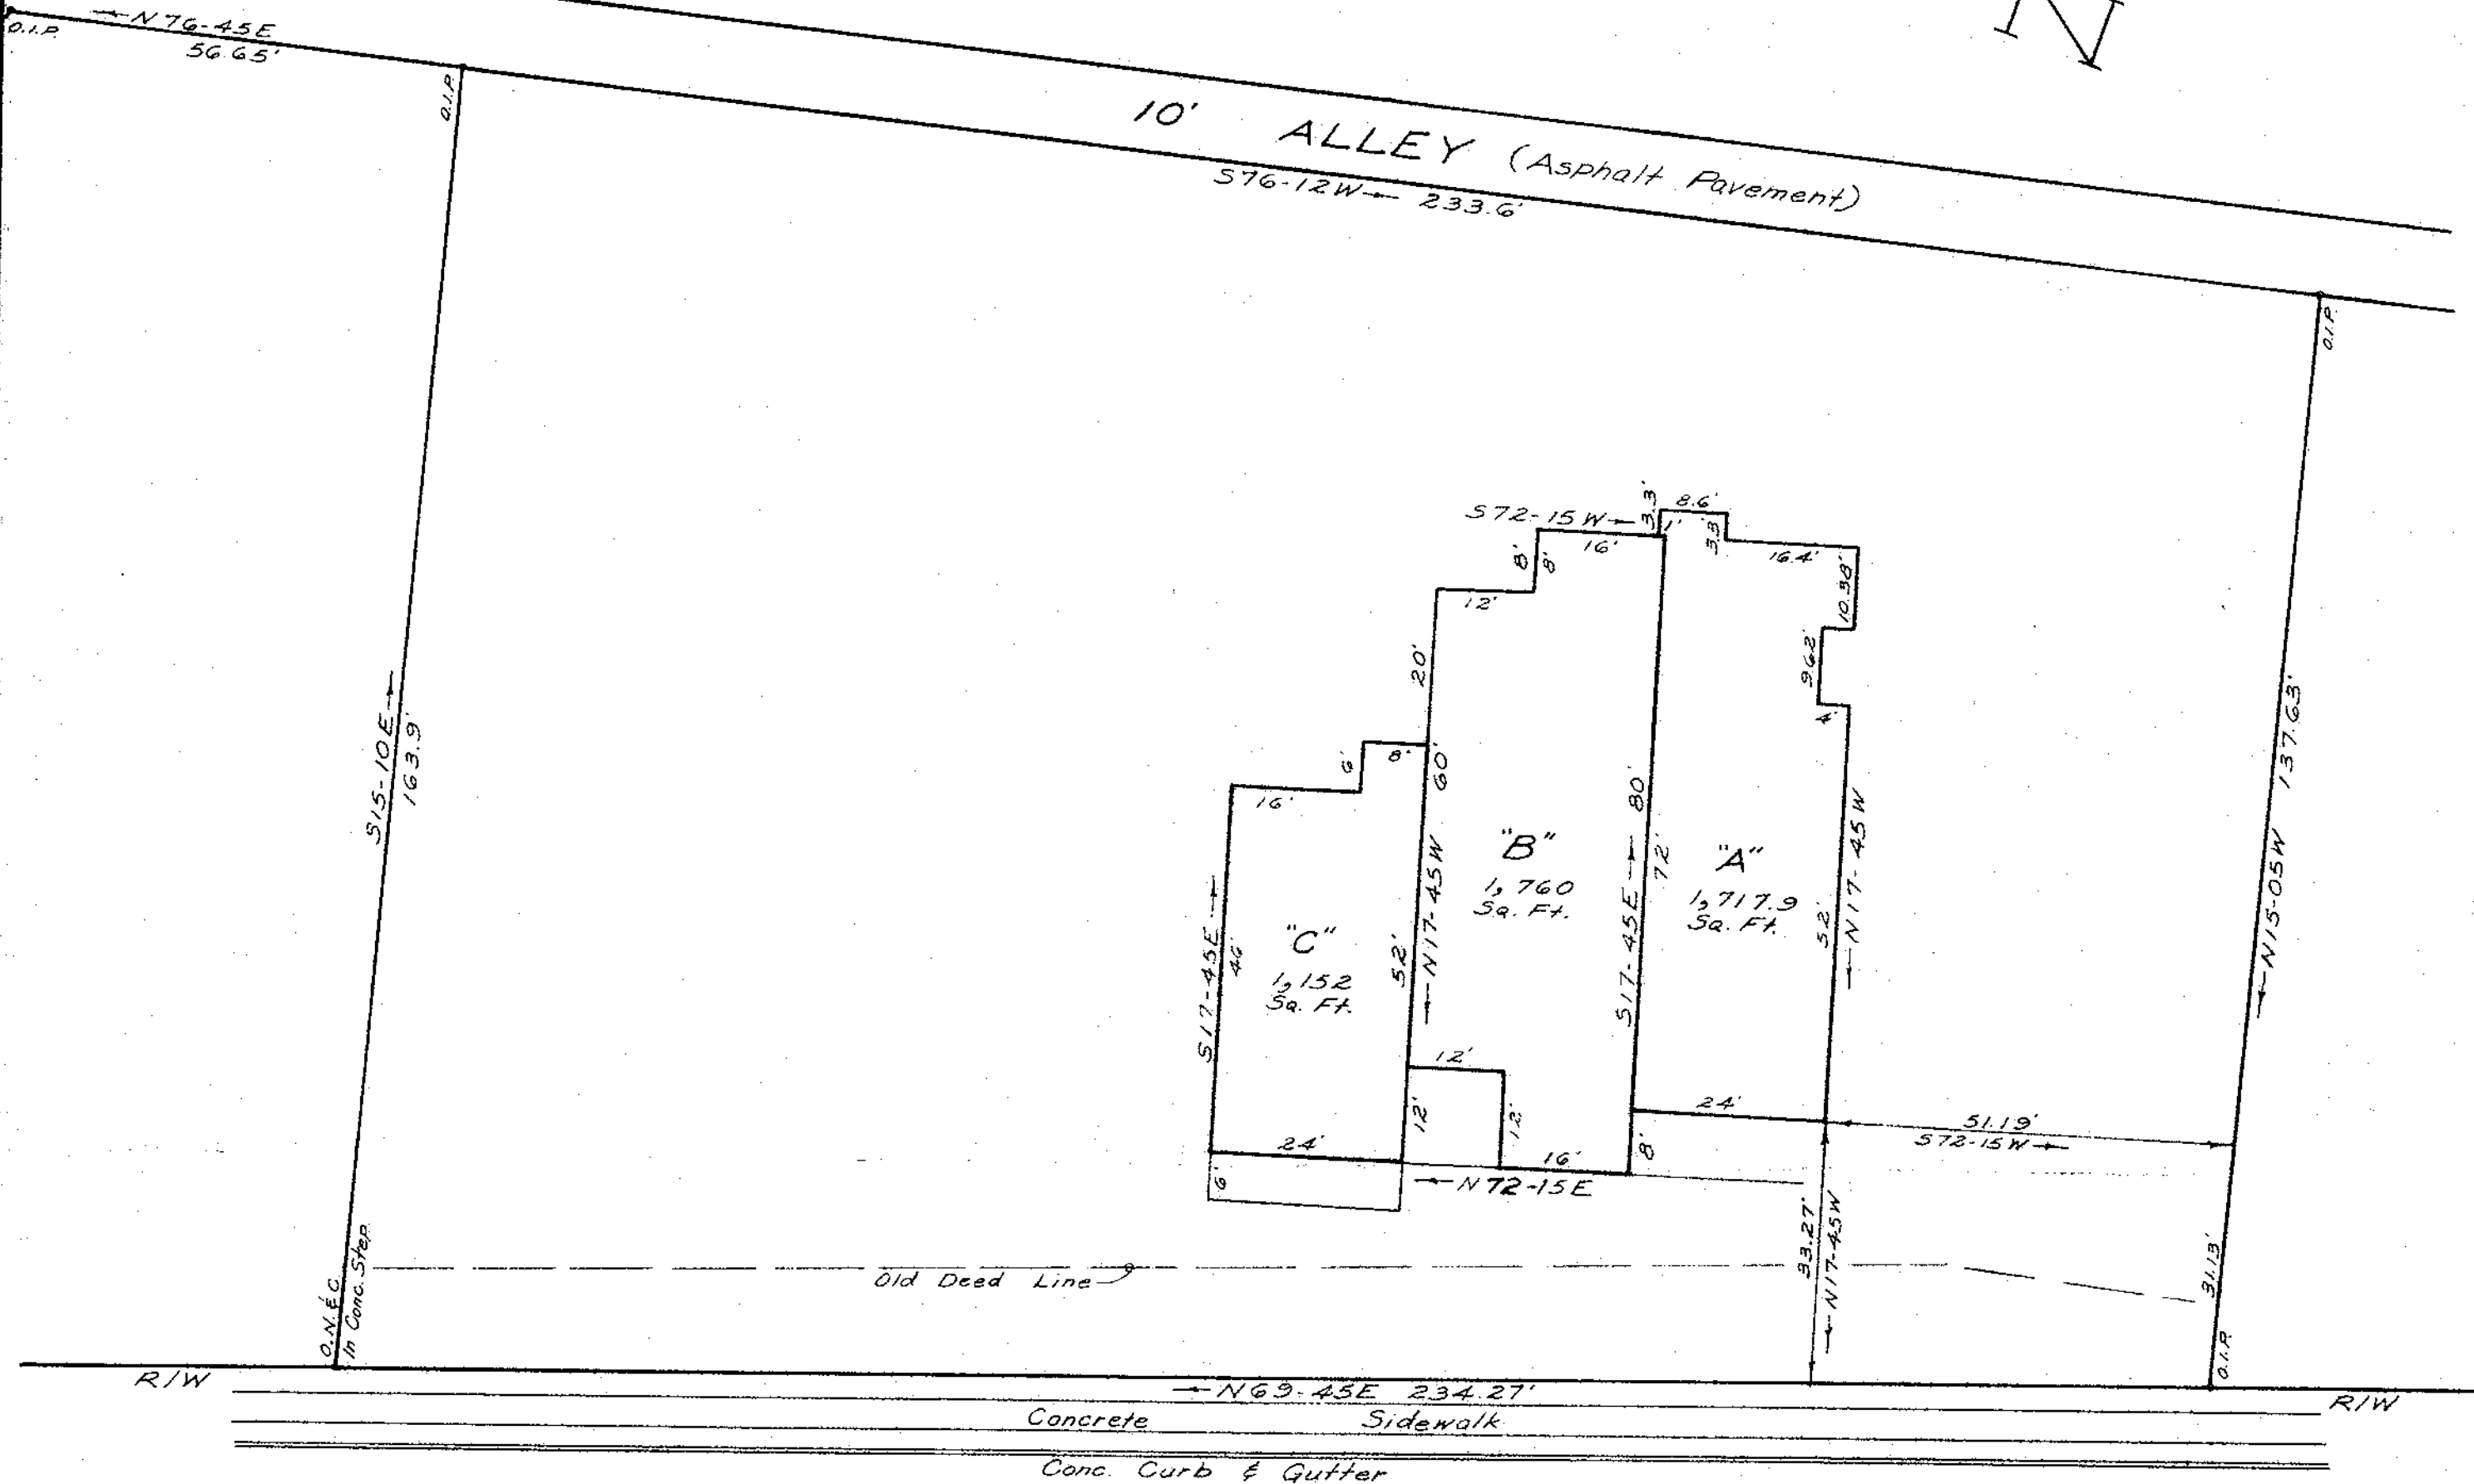


FILED
GREENVILLE CO. S.C.
MAR 29 3 43 PM '84
DONNIE S. TANKERSLEY
R.M.C.

MICROFILMED

PETTIGRU ST.

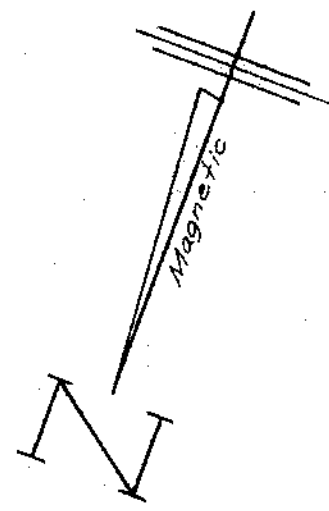

EAST NORTH STREET RAMP

Area 35,202 Sq. Ft. = 0.81 Acre

AS BUILT SURVEY

FOR

MAR 29 1984

JAMES D. MILLER

10-K-16


GREENVILLE, S.C.

✓30159

JULY, 1983
Revised March 22, 1984



W. R. WILLIAMS, JR.
ENGR./SURVEYOR, Inc.
P. E. & L. S. No. 3979
15 S. MAIN STREET
TRAVELERS REST, S. C.
29690

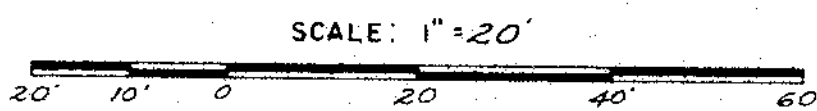

47-2-466

"I hereby certify that the ratio of precision of the field survey is 1/4000 and the area was determined by a method of area calculation."

W.R. Williams, Jr. P.E. & L.S. No. 3979

5039

3 MAR 29 1984 052
3 MAR 29 1984 053

5.0000
5.0000