



MICROFILM

FILED
GREENVILLE CO. S.C.
JUN 7 9 37 AM '84
DONNIE S. TARRERSLEY
R.M.C.

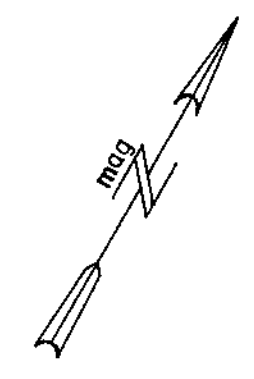

PELHAM RD. 66' R/W

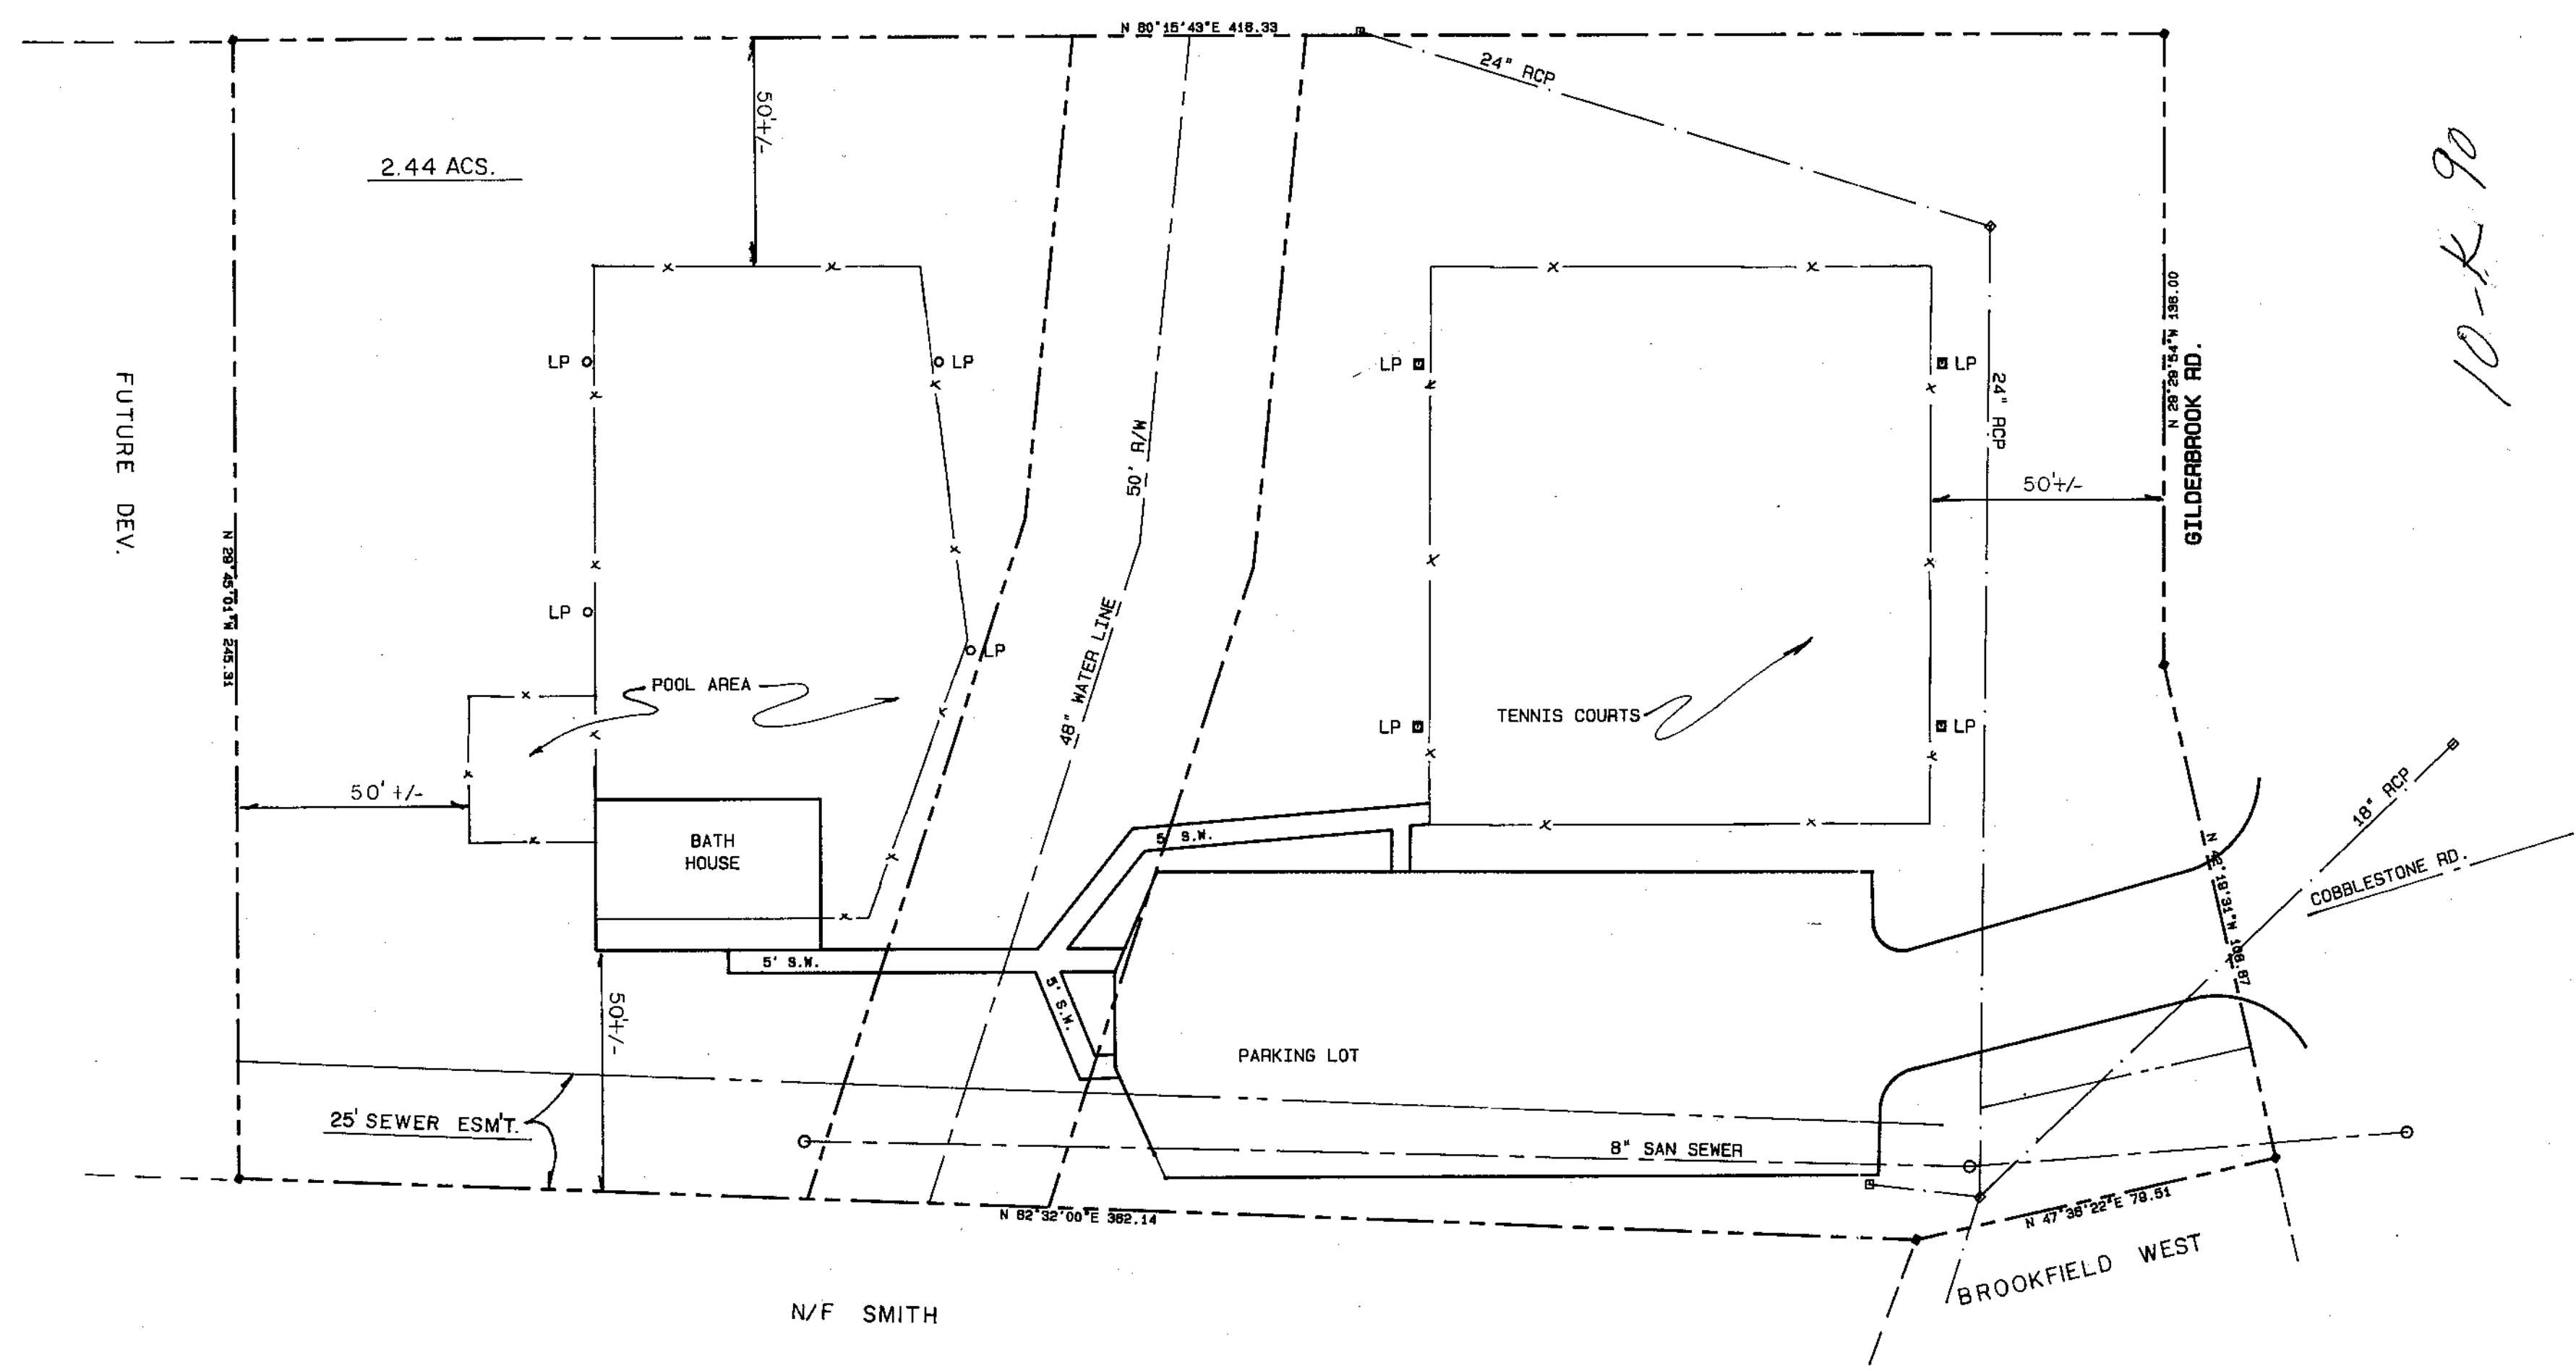

10-K-90


38783

I certify that this plat was made under my supervision and to the best of my knowledge is correct and the ratio of precision of the field survey is 1/10,000 min. as shown hereon and the area is by the D.M.D. method.

HEANER ENGINEERING CO., INC.
BY: *[Signature]*
REGISTERED LAND SURVEYOR
SC REG. NO. 8571 5/23/84



Heaner engr. co., inc.
greenwood, S.C.

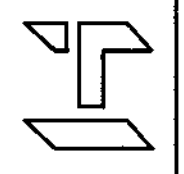

AS-BUILT
SURVEY

BROOKFIELD
REC. AREA

DATE: 5/23/84
SCALE: 1"=30'
DESIGN BY: _____
DRAWN BY: _____
CHECKED BY: _____
APPROVED BY: _____

5070 JUN 7 84 620

5-0001