


- EASEMENTS:
1. NON EXCLUSIVE MUTUAL PARKING EASEMENT IS RESERVED IN DEED BOOK 1030, PAGE 210 OVER 38' WIDE EASEMENT AREA, 24' EASEMENT FOR INGRESS AND EGRESS AND ASPHALT PARKING AREA HEREON.
  2. RIGHT-OF-WAYS AND EASEMENTS TO THE CITY OF GREENVILLE FOR INSTALLING AND MAINTAINING ALL SANITARY SEWER LINES HEREON RECORDED IN DEED BOOK 1181, PAGE 416 AND DEED BOOK 1181, PAGE 777.

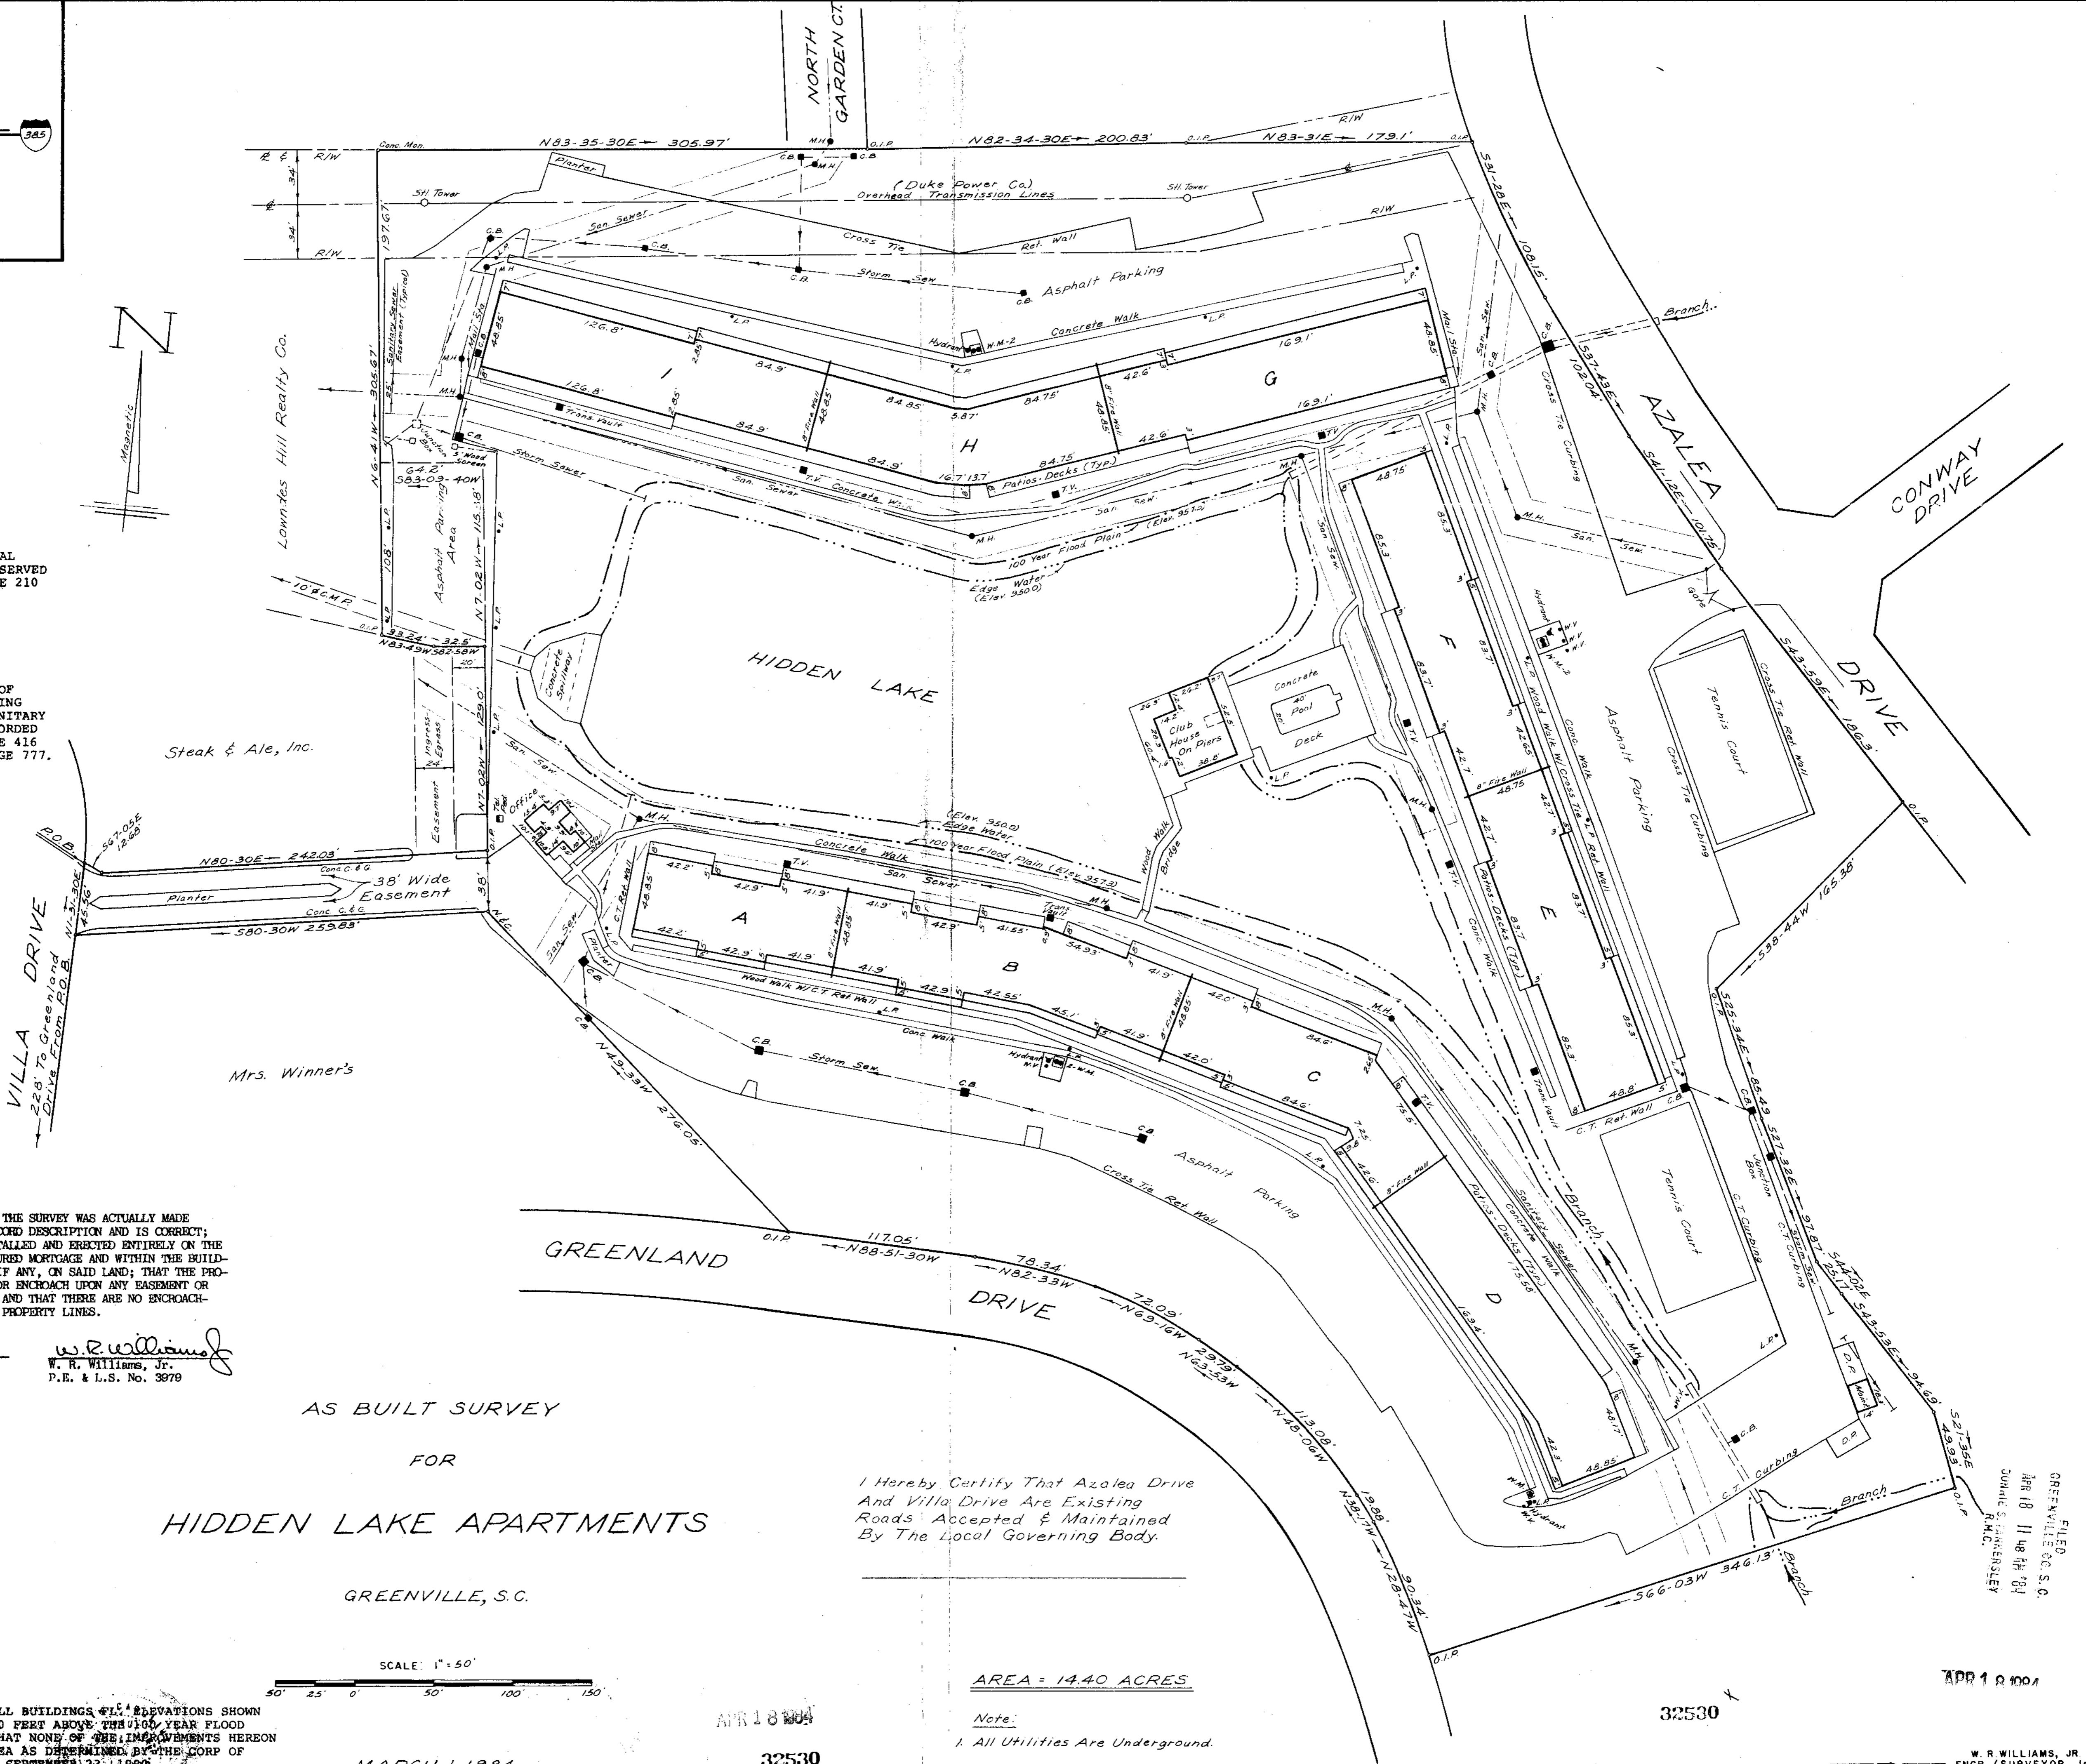

THIS IS TO CERTIFY THAT THE SURVEY WAS ACTUALLY MADE ON THE GROUND AS PER RECORD DESCRIPTION AND IS CORRECT; THAT THE PROJECT IS INSTALLED AND ERRECTED ENTIRELY ON THE LAND COVERED BY THE INSURED MORTGAGE AND WITHIN THE BUILDING RESTRICTION LINES, IF ANY, ON SAID LAND; THAT THE PROJECT DOES NOT OVERHANG OR ENCRUCH UPON ANY EASEMENT OR RIGHT-OF-WAY OF OTHERS, AND THAT THERE ARE NO ENCRUCHMENTS EITHER WAY ACROSS PROPERTY LINES.

Dated: 4/17/84  
 W. R. Williams, Jr.  
 P.E. & L.S. No. 3979


AS BUILT SURVEY  
 FOR  
**HIDDEN LAKE APARTMENTS**  
 GREENVILLE, S.C.

I Hereby Certify That Azalea Drive And Villa Drive Are Existing Roads Accepted & Maintained By The Local Governing Body.

FILED  
 GREENVILLE, S.C. S.C.  
 APR 18 11 48 AM '84  
 JENNIE S. JAMES/RSLEY  
 R.M.C.

I HEREBY CERTIFY THAT ALL BUILDINGS AND ELEVATIONS SHOWN HEREON ARE A MIN. OF 2.0 FEET ABOVE THE 100 YEAR FLOOD PLAIN ELEV. 957.3 AND THAT NONE OF THE IMPROVEMENTS HEREON ARE IN A FLOOD PRONE AREA AS DETERMINED BY THE CORP OF ENGINEERS, LETTER DATED SEPTEMBER 23, 1968.

DATED: 4/17/84  
 W. R. Williams, Jr.  
 P.E. & L.S. No. 3979

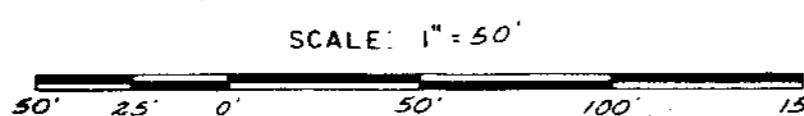

MARCH 1, 1984  
 32530

AREA = 14.40 ACRES

- Note:
1. All Utilities Are Underground.
  2. All Apartment Buildings Are 3 Stories.

10-K-43

10-K-44

W.R.W. ENGR./SURVEYOR, Inc.  
 P.E. & L.S. No. 3979  
 15 S. MAIN STREET  
 TRAVELERS REST STOP  
 APR 18 1984  
 JENNIE S. JAMES/RSLEY  
 R.M.C.

APR 18 1984