


FILED
 GREENVILLE CO. S.C.
 MAY 1 9 28 AM '84
 DONNIE S. TANKERSLEY
 R.M.C.

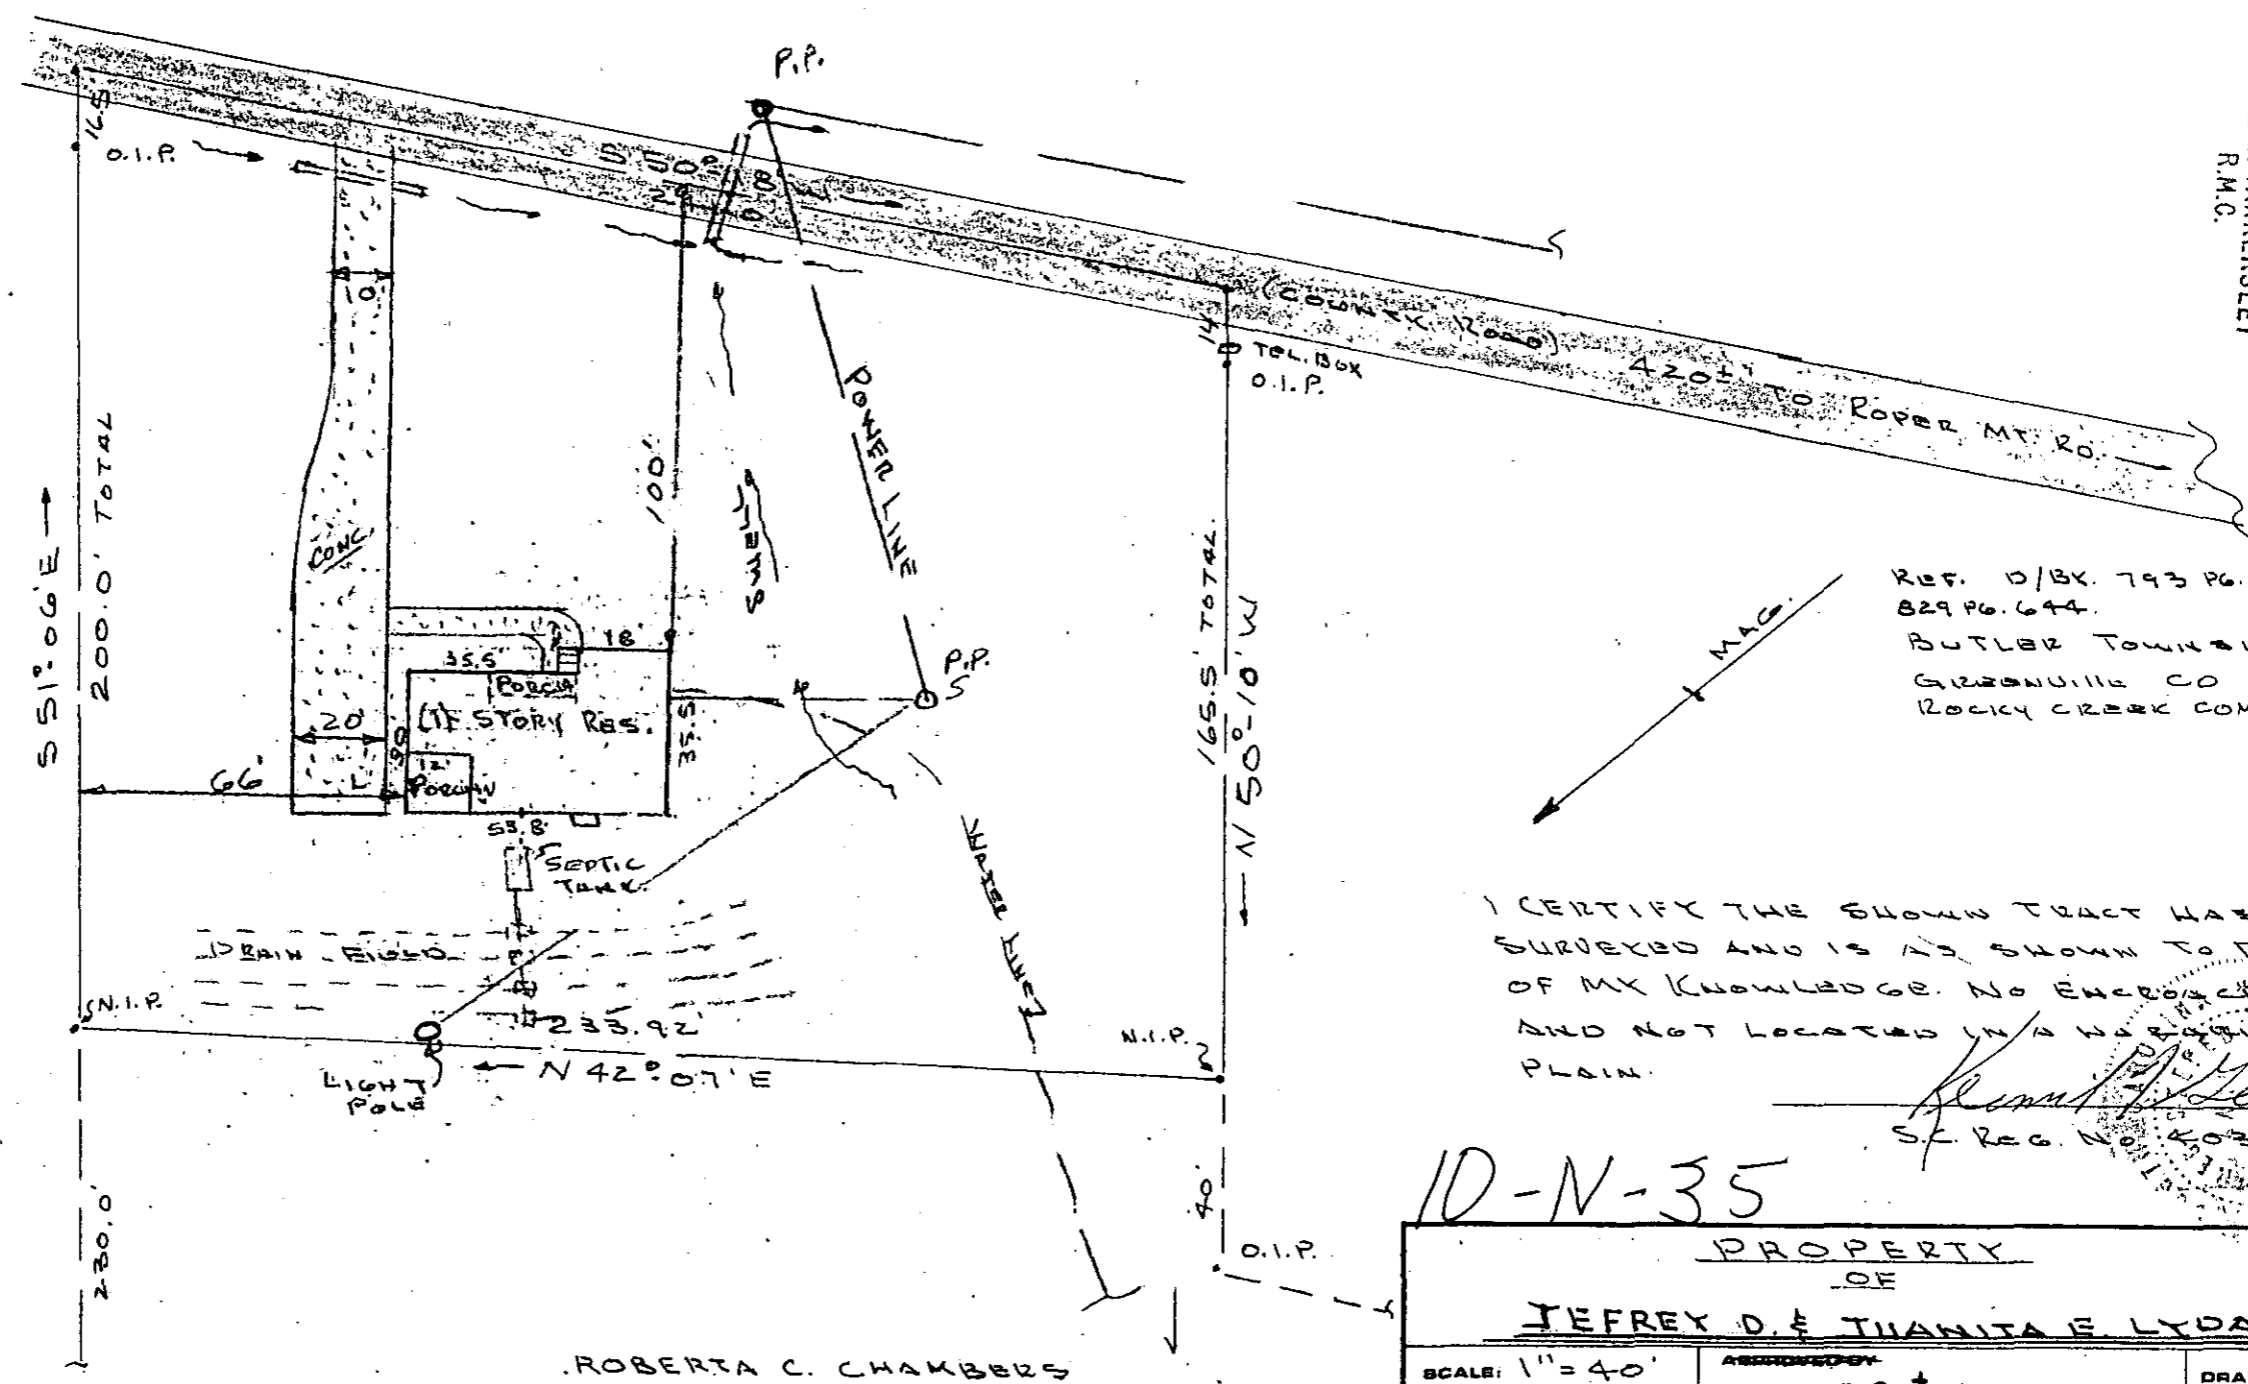


REF. D/BX. 793 PG. 266, 801 PG. 213,
 829 PG. 644.
 BUTLER TOWNSHIP
 GREENVILLE CO
 ROCKY CREEK COMMUNITY.

I CERTIFY THE SHOWN TRACT HAS BEEN SURVEYED AND IS AS SHOWN TO THE BEST OF MY KNOWLEDGE. NO ENCROACHMENTS AND NOT LOCATED IN A NEARLY PLAIN.

K.T. Gould
 S.F. REG. NO. 10350

10-N-35

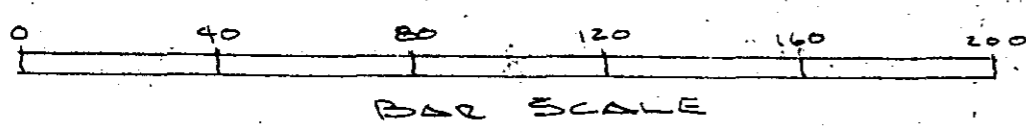

34198

PROPERTY OF		DRAWN BY K.T.G.	
JEFFREY D. & THANITA E. LYDA		0.99 ± AC	
SCALE: 1" = 40'	ABSTRACT NO.	DATE: 4-24-84	
"AS BUILT"			
K.T. GOULD INC. 3 MYO 84 009		DRAWING NUMBER 3.000.0	
		707	

MICROFILMED