
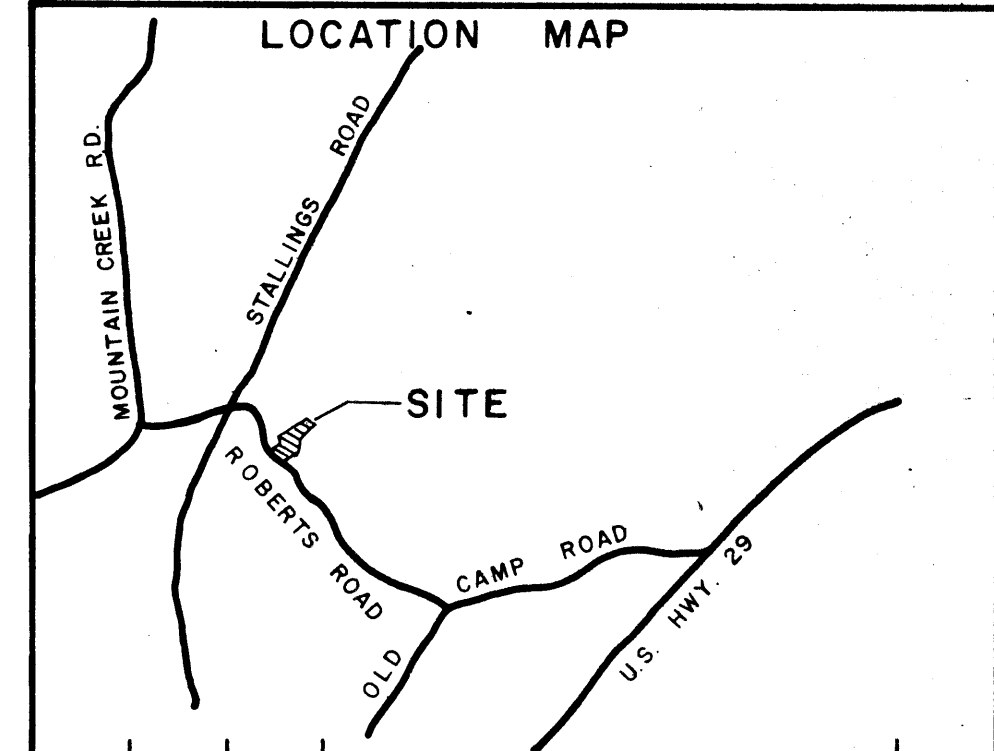


NOTES:

LEGEND

1. This is an "as built" survey showing the locations of said buildings which have been completed except for balconies at the rear of units 3 and 4 which were under construction at the time the survey was performed.
2. The additional sheets of this Exhibit show typical floor plans for the units, their location in each building, and typical front building elevations.
3. Each unit consists of the space bounded by the undercoated and/or unfinished surfaces of the perimeter walls, floors and ceilings.
4. All interior angles in units are 90 degrees unless otherwise noted.
5. Locations of structures defined by use of coordinate grid based on magnetic North.

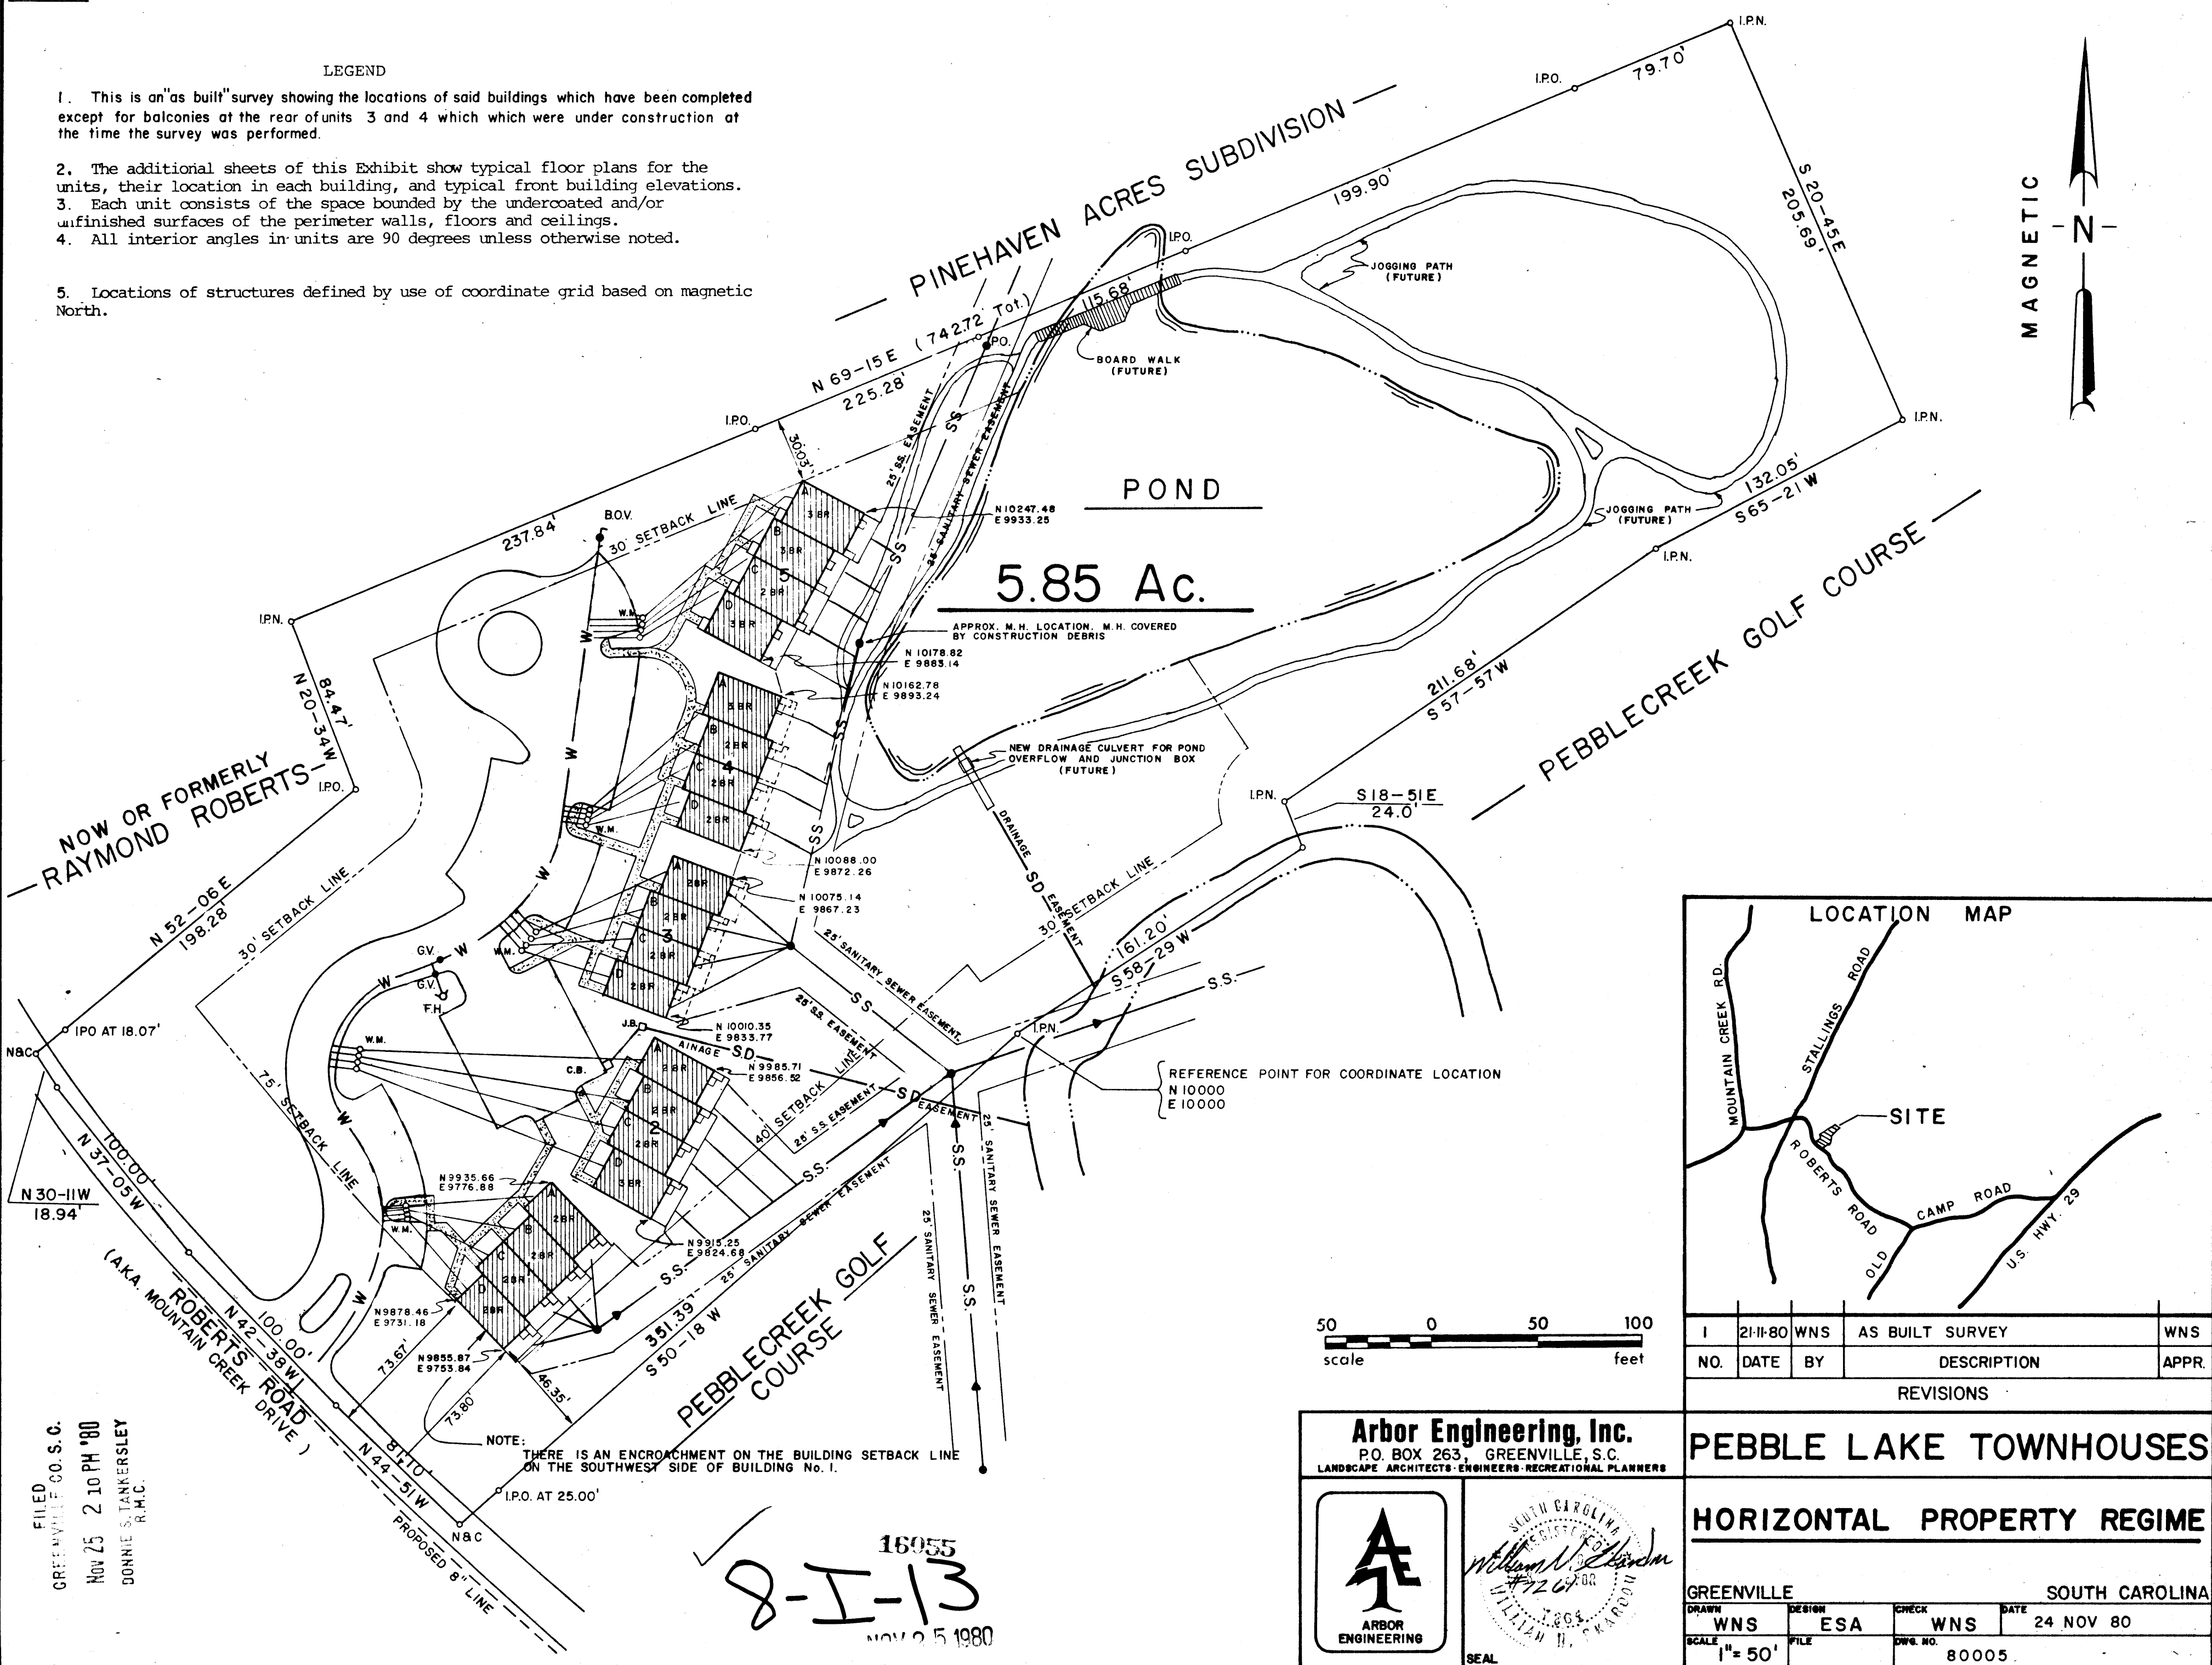

NO.	DATE	BY	DESCRIPTION	APPR.
1	2-11-80	WNS	AS BUILT SURVEY	WNS
REVISIONS				


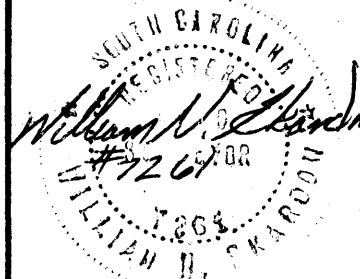
PEBBLE LAKE TOWNHOUSES

HORIZONTAL PROPERTY REGIME

GREENVILLE SOUTH CAROLINA

DRAWN	DESIGN	CHECK	DATE
WNS	ESA	WNS	24 NOV 80
SCALE	FILE	DWG. NO.	
1" = 50'		80005	

Arbor Engineering, Inc.
P.O. BOX 263, GREENVILLE, S.C.
LANDSCAPE ARCHITECTS-ENGINEERS-RECREATIONAL PLANNERS

SEAL

FILED
GREENVILLE CO. S.C.
NOV 25 2 10 PM '80
DONNIE S. TANKERSLEY
R.H.C.

8-I-13

16055
NOV 25 1980

GCTO 1 NC2580 1577 5.0001

MICROFILMED