

GREENVILLE, S.C. CORRETT
EST. 5-2768 W.A. Hancock
CODE 57C Mrs. J. J. Jagan.


Toll Line } GREENVILLE-FAULKNER
Or Exchange Line } (Exchange)
tributary to }
The Property is bounded where the line enters and leaves
this property by the property of:

H.K. TOWNES on the E. and
WALLACE CORDELL on the W.

Number of poles covered by this permit _____
Number of Guys and Anchors _____

The poles have the following numbers:
AT No. P-66 to No. _____

Poles are located on private property and in Streets and
Highways as shown on the following diagram.

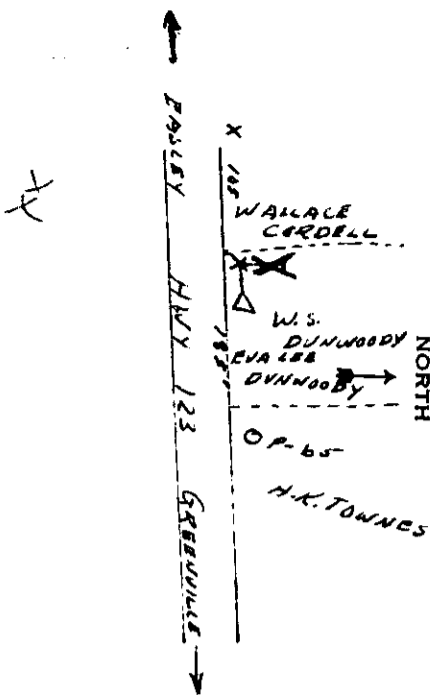

GENERAL PERMIT

Form 6196-A (Sept., '40)

\$ 1.00 Received of the SOUTHERN BELL TELEPHONE AND TELEGRAPH COMPANY, (INCORPORATED)

One + 70/100 Dollars in consideration of which WE hereby grant unto said Company, its associated and allied companies, their respective successors and assigns, the right, privilege and authority to construct, operate and maintain its lines of Telephone and Telegraph, and for the general transmission of intelligence, consisting of such poles, wires, cables, conduits, guys, anchors and other fixtures and appurtenances as the grantee may from time to time require, upon, across, over and/or under the property which WE own or in which WE have any interest in the County of GREENVILLE and State of S.C., and upon, along and/or under the roads, streets, or highways adjoining the said property, and the right to permit the attachment of and/or carry in conduit wires and cables of any other company of person, and with the further right to trim and cut down and to keep trimmed and cut down all trees and undergrowth within 10 feet of said line, and in addition thereto, the grantee shall have the right to cut down, from time to time, all dead, weak, leaning or dangerous trees that are tall enough to reach the wires in falling; said sum being received in full payment for the rights herein granted.

Located along Highway 123.

Witness OUR hand and seal this 28 day of MAY 1952 at GREENVILLE, S.C. RTE 1 (Post Office Address)

Witness W.A. Hancock Mrs W.A. Hancock W.S. Dunwoody Mrs. Eva Lee Dunwoody (L.S.) (L.S.) (Land Owner) W.S. DUNWOODY 1192 EVA LEE DUNWOODY

JUL 14 1952

STATE OF SOUTH CAROLINA
COUNTY OF GREENVILLE

Personally appeared before me W.A. Hancock and made oath that he saw the within named W.S. Dunwoody sign, seal and as his her their act and deed, deliver the within instrument, and that he with Mrs. W.A. Hancock witnessed the execution thereof.

Sworn to before me, this 14th day of July A.D. 1952 W.A. Hancock

Bennie Ward Sinclair (Seal) Notary Public, S.C.

Recorded July 14th. 1952 at 10:42 A. M. #15530