

GREENVILLE, S.C.
NO. 33-2379
CODE 9-C X

Toll Line } GREENVILLE-FASSLEY
(Name)

Or Exchange Line }
tributary to (Exchange)

The Property is bounded where the line enters and leaves this property by the property of:

JACK ISRAEL on the W and
HORE HUGHEY on the E


Number of poles covered by this permit 1

Number of Guys and Anchors

The poles have the following numbers:

from No. 142 1/2 to No.

Poles are located on private property and in Streets and Highways as shown on the following diagram.

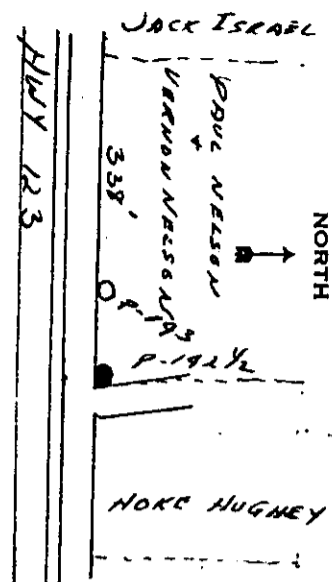

GENERAL PERMIT

24115 X

Form 6196-A (Sept., '40)

Received of the SOUTHERN BELL TELEPHONE AND TELEGRAPH COMPANY, (INCORPORATED)

One x no /100 Dollars in consideration of which I hereby grant unto said Company, its associated and allied companies, their respective successors and assigns, the right, privilege and authority to construct, operate and maintain its lines of Telephone and Telegraph, and for the general transmission of intelligence, consisting of such poles, wires, cables, conduits, guys, anchors and other fixtures and appurtenances as the grantee may from time to time require, upon, across, over and/or under the property which I own or in which I have any interest in the County of PICKENS and State of S.C. and upon, along and/or under the roads, streets, or highways adjoining the said property, and the right to permit the attachment of and/or carry in conduit wires and cables of any other company or person, and with the further right to trim and cut down and to keep trimmed and cut down all trees and undergrowth within 15 feet of said line, and in addition thereto, the grantee shall have the right to cut down, from time to time, all dead, weak, leaning or dangerous trees that are tall enough to reach the wires in falling; said sum being received in full payment for the rights herein granted.

Witness OUR hand and seal this 30 day of OCT 1953 at GREENVILLE, S.C. (Post Office Address)

Witness Walter Perry
W. A. Hancock

Paul Nelson (L.S.)
Vernon Nelson (L.S.)
PAUL NELSON (Land Owner)
VERNON NELSON

STATE OF SOUTH CAROLINA
COUNTY OF GREENVILLE

Personally appeared before me W. A. Hancock and made oath that he saw the within name Paul Nelson and Vernon Nelson sign, seal and as his her first and last distribute the within instrument, and that he with Walter Perry witnessed the execution thereof.

Sworn to before me, this 4th day of Nov A.D. 1953 W. A. Hancock

Bessie Ward Sinclair
Notary Public, S. C.

Recorded November 4th, 1953 at 3:00 P. M. #24115