

K.C. 3-8213-A 9-TL

545-511

Toll Line } GREENVILLE SIMPSONVILLE
(Name)

Or Exchange Line }
tributary to (Exchange)

The Property is bounded where the line enters and leaves this property by the property of:

William Callaway on the N and

U.S. HWY # 276 on the S

Number of poles covered by this permit


Number of Guys and Anchors 1

The poles have the following numbers:

from No. 38 to No. _____

Poles are located on private property and in Streets and Highways as shown on the following diagram.

NORTH

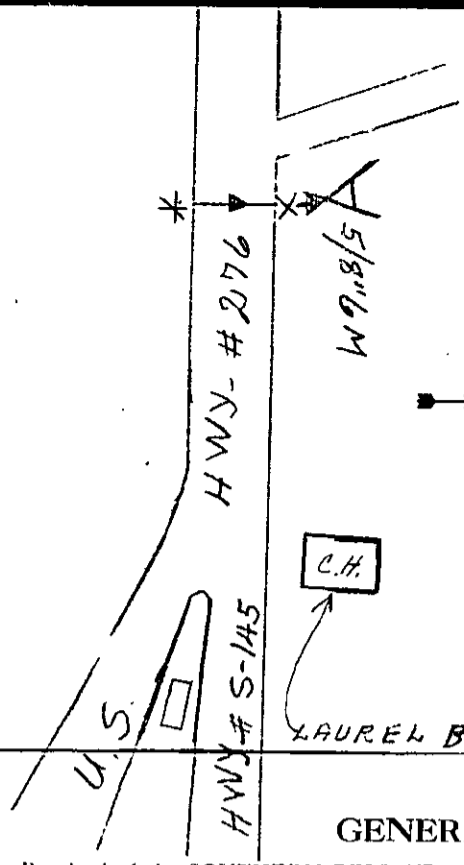

GENERAL PERMIT

FEB 20 1956

Form 6196-A (Sept. '40)

\$ 1.00 Received of the SOUTHERN BELL TELEPHONE AND TELEGRAPH COMPANY,

One and NO/100 Dollars in consideration of which I hereby grant unto said Company, its associated and allied companies, their respective successors and assigns, the right, privilege and authority to construct, operate and maintain its lines of Telephone and Telegraph, and for the general transmission of intelligence, consisting of such poles, wires, cables, conduits, guys, anchors and other fixtures and appurtenances as the grantee may from time to time require, upon, across, over and/or under the property which I own or in which I have any interest in the County of Greenville and State of S.C. and upon, along and/or under the roads, streets, or highways adjoining the said property, and the right to permit the attachment of and/or carry in conduit wires and cables of any other company or person, and with the further right to trim and cut down and to keep trimmed and cut down all trees and undergrowth within 5 feet of said line, and in addition thereto, the grantee shall have the right to cut down, from time to time, all dead, weak, leaning or dangerous trees that are tall enough to reach the wires in falling; said sum being received in full payment for the rights herein granted.

Witness my hand and seal this 9th day of Feb 1956, at Greenville, S.C.
 Witness W.H. Harder
W. T. WYATT

H. J. Southern (L. S.)
H. J. SOUTHERN (Land Owner) (L. S.)

STATE OF SOUTH CAROLINA
COUNTY OF GREENVILLE

Personally appeared before me W. H. Harder and made oath that he was the owner of the property named H. J. Southern and that he had authorized the execution of the instrument, and W. T. Wyatt witnessed the execution

Sworn to before me on 22nd day of Feb, 1956, at Greenville, S.C. W. H. Harder

H. Leo Beckwith (SEAL) # 4686
 Notary Public, S. C. Recorded Feb. 22, 1956 at 11:58 A.M.