


EE9TA # 1268 A

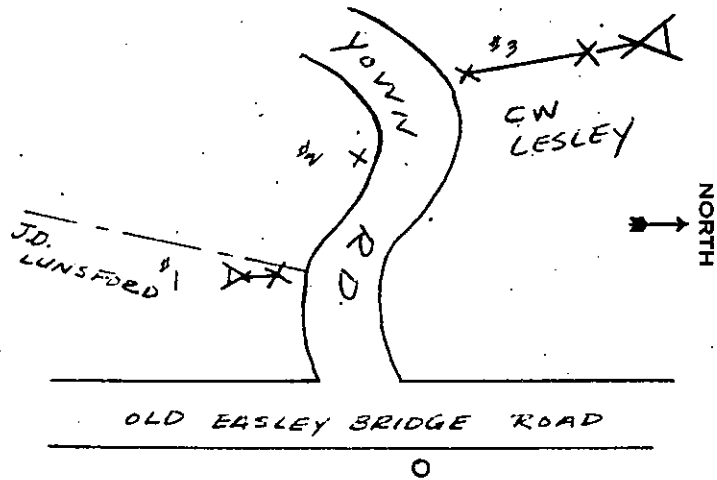

Name and Post Office Address of Grantor: C.W. LESLEY
RT 8 Box 21
GREENVILLE, S.C.

Toll Line _____ (Name)
 Or Exchange Line GREENVILLE S.C. (Exchange)
 tributary to _____

The Property is bounded where the line enters and leaves this property by the property of:
YOWN RD on the S.E. and YOWN RD on the S.W.

The poles (or stakes) have the following identification: 3 to _____

Authority: 63-2319 Classification: 4-C

Area: GREENVILLE S.C.

Approved: J.H. Ferguson

Title: SRV. ENGINEER

GEP 47.101

CLEARANCE PERMIT

(INDIVIDUAL) Form 8422 Nov. '54

Received of the SOUTHERN BELL TELEPHONE AND TELEGRAPH COMPANY One and _____ No. _____ /100 Dollars in consideration of which (I) (~~We~~) hereby grant said Company, its associated and allied companies, their respective successors and assigns, the right to clear and keep cleared trees and undergrowth within at least 5 feet on both sides of the center line of said Company's line on or adjacent to my property in the City of GREENVILLE, County of GREENVILLE, State of South Carolina and the further right to set and maintain on said property 1 POLE GUY + anchors, and attach thereto the necessary guy wires, said sum being received in full payment therefor.

JAN 11 1957

Executed Nov. 6, 1956

Witness:

930
Mrs. Lula G. Lesley
J.H. Ferguson

Charles W. Lesley (L.S.)
 _____ (L.S.)
 _____ (L.S.)
 _____ (L.S.)
 CHARLES W. LESLEY (J.H.F.)

GEP 47.101

ACKNOWLEDGMENTS
 For Use in South Carolina

Form 8425 Nov. '54

Individual Form

STATE OF SOUTH CAROLINA }
 COUNTY OF GREENVILLE } ss.

Personally appeared before me J.H. FERGUSON
 and made oath that ~~(she)~~ (he), with MRS. LULA G. LESLEY saw the within named
CHARLES W. LESLEY
 _____ sign,
 seal, and deliver as (his) (~~her~~) (~~their~~) act and deed the within written instrument, and that (he) (~~she~~) with the
 said MRS. LULA G. LESLEY witnessed the execution thereof.

Sworn to before me this 11th day of Jan, A.D. 1957
J.H. Ferguson
 Notary Public

Recorded January 11th, 1957, at 2:41 P.M.
 #930