


ER977A SMT. 704-596-B

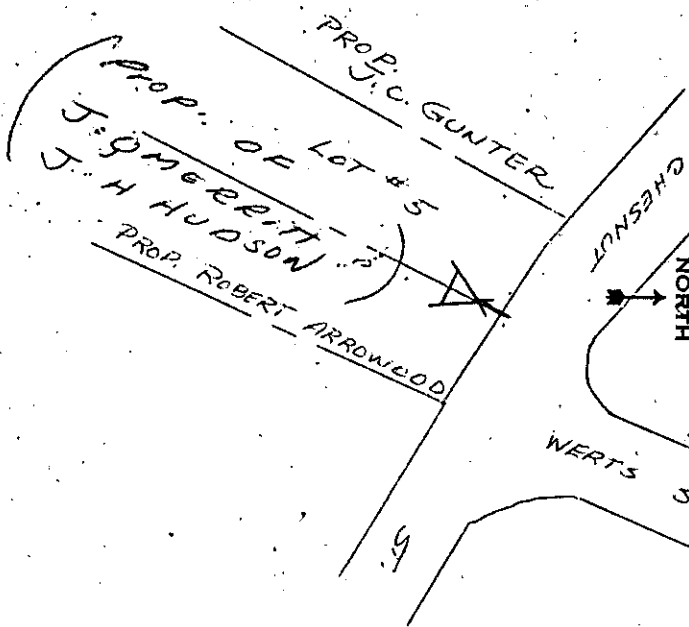

Name and Post Office Address  
 of Grantor J. Q. MERRITT - #1508  
EASLEY BRIDGE RD. - GREENVILLE, S.C.  
J. H. HUDSON - #34 TIVDAL AVE.  
GREENVILLE, S.C.

Toll Line \_\_\_\_\_ (Name)  
 Exchange Line GREENVILLE S.C. (Exchange)  
 tributary to \_\_\_\_\_

The Property is bounded where the line enters and leaves this property by the property of:  
J. C. GUNTER on the WNW and  
ROBERT ARROWOOD on the ESE  
 The poles (or stakes) have the following identification: ANCHORS to \_\_\_\_\_  
 Authority 23-1255 Classification G.C.  
 Area GREENVILLE S.C.  
 Approved \_\_\_\_\_  
 Title \_\_\_\_\_

GEP 47.101

MAY 6 1957 CLEARANCE PERMIT 10779

(INDIVIDUAL) Form 8422 Nov. '54

Received of the SOUTHERN BELL TELEPHONE AND TELEGRAPH COMPANY One and no /100 Dollars in consideration of which (We) hereby grant said Company, its associated and allied companies, their respective successors and assigns, the right to clear and keep cleared trees and undergrowth within at least 5 feet on both sides of the center line of said Company's line on or adjacent to my property in the City of Greenville, County of Greenville, State of South Carolina, and the further right to set and maintain on said property One (1) anchors, and attach thereto the necessary guy wires, said sum being received in full payment therefor. On a certain tract of land along Chesnut Street, bounded on the east south east by Robert Arrowood, on the west north west by J. C. Gunter and on the north north east by Chesnut Street.

Executed April 19, 1957  
 \_\_\_\_\_ (L.S.)  
 \_\_\_\_\_ (L.S.)  
 \_\_\_\_\_ (L.S.)  
 \_\_\_\_\_ (L.S.)  
 J. Q. Merritt  
 J. H. Hudson

Witness:  
 \_\_\_\_\_  
 \_\_\_\_\_

GEP 47.101

Form 8425 Nov. '54

ACKNOWLEDGMENTS For Use in South Carolina

Individual Form

STATE OF SOUTH CAROLINA }  
COUNTY OF GREENVILLE } ss.

Personally appeared before me J. H. FERGUSON  
 and made oath that (he) (~~she~~), with F. L. MCCRAN saw the within named  
J. Q. MERRITT AND J. H. HUDSON  
 \_\_\_\_\_ sign,  
 seal, and deliver as (~~his~~) (~~her~~) (their) act and deed the within written instrument, and that (he) (~~she~~) with the  
 said F. L. MCCRAN witnessed the execution thereof.

Sworn to before me this 3 day of May, A.D. 1957  
 \_\_\_\_\_  
 Notary Public

Recorded May 6th, 1957 at 3:09 P.M. #10779