

ACKNOWLEDGMENTS  
For Use in South Carolina

OCT 24 1962

Individual Form


STATE OF SOUTH CAROLINA }  
COUNTY OF GREENVILLE } SS.

Personally appeared before me John H. Ferguson  
and made oath that (he) (she), with TRUMAN H. DICKSON saw the within named  
Rev. J.A. Pittman And Maggie Bishop Pittman


sign,  
seal, and deliver as (his) (her) (their) act and deed the within written instrument, and that (he) (she) with the  
said TRUMAN DICKSON witnessed the execution thereof.

Sworn to before me this  
20 day of October A.D. 1962

John H. Ferguson  
John H. Ferguson

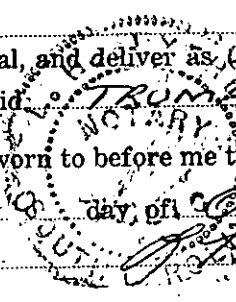

Notary Public

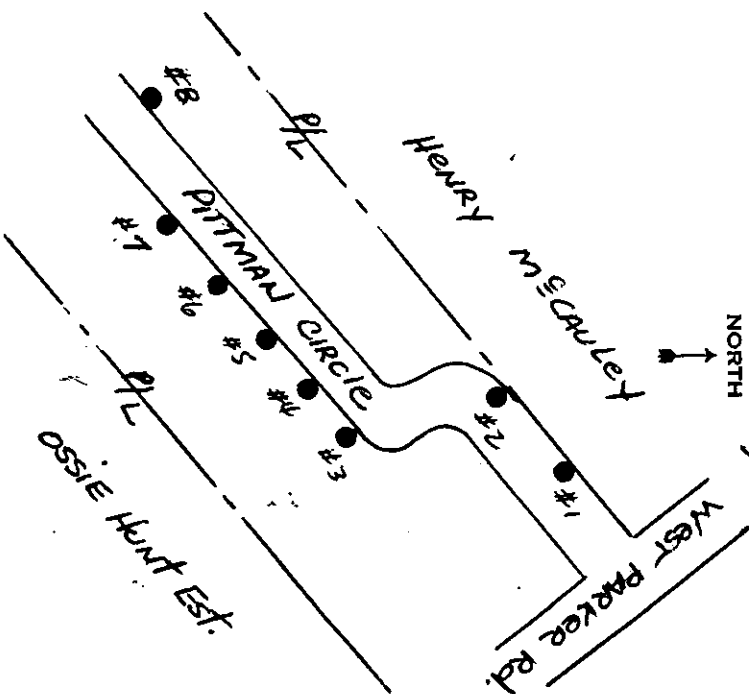

The poles (or stakes) have the following identifica-  
tion: #1 to #8  
Authority: 23-1954 Classification 1-C.  
Area: GREENVILLE S.C.  
Approved: J.H.F.  
Title: Supv Eas

The Property is bounded where the line enters and  
leaves this property by the property of:  
West Parker Rd. on the NE and  
on the

Or  
Exchange Line  
tributary to  
{ Greenville, S.C.  
(Name)  
(Exchange)

Name and  
Post Office Address  
of Grantor J.A. & Maggie B  
Pittman #1907 West  
Parker Road, Greenville, S.C.

GENERAL PERMIT

Received of the SOUTHERN BELL TELEPHONE AND TELEGRAPH COMPANY ONE AND --- No/100  
Dollars in consideration of which (I) (We) hereby grant said Company, its associated and allied companies, their respective  
licensees, successors and assigns, the right to construct, operate and maintain a line of communication consisting of such poles, wires,  
cables, conduits, guys, anchors and other necessary appurtenances as from time to time are required upon, across, over and/or under  
that certain tract of land situated in GREENVILLE, County, State of SOUTH CAROLINA, to-wit: THAT TRACT  
of land lying S.W. of West Parker Road bounded on the N.W. by  
HENRY McCAULEY on the S.E. by the Ossie Hunt Estate.

and upon, along and under the roads, streets, or highways adjoining or through said property with the right to permit the attach-  
ment of and/or carry in conduit wires and cables of any other person or company for communications purposes or for the transmission  
and distribution of electric power and the right of ingress and egress to said premises at all times for the purpose of inspecting and  
maintaining said line and with the right to clear and keep cleared all trees, undergrowth or other obstructions within a strip of land  
Ten (10) feet on each side of the center of said line and to trim and cut and keep trimmed and cut all dead, weak, leaning or dan-  
gerous trees which might reach said line in falling; including the right to relocate said line on said premises to conform to any  
future highway relocation, widening or improvement; the said sum being received in full payment for the rights herein granted.

Signed, sealed and delivered in the presence of:  
Truman H. Dickson  
John H. Ferguson  
Recorded October 24th, 1962  
at 3:31 P.M. #10931

Executed September 26, 1962  
Rev. J.A. Pittman (SEAL)  
Maggie B. Pittman (SEAL)  
Maggie Bishop  
NEE: MAGGIE BISHOP