


GREENVILLE CO. S. C.

MAY 4 2 48 PM 1954

OLLIE E. WORTH, R.M.C.

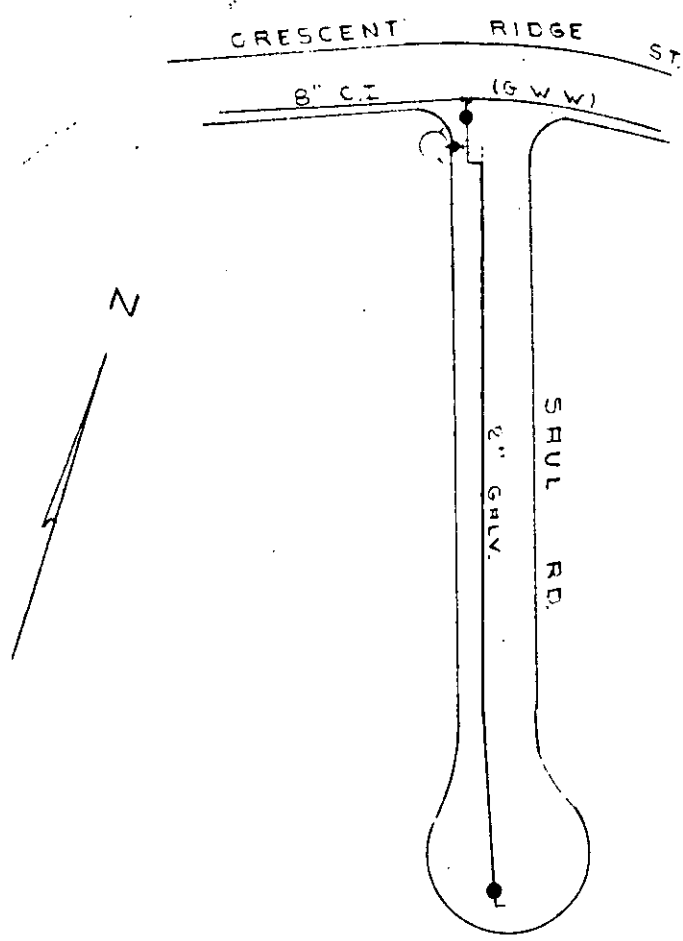

Installed 1950
 465' ± - 2" GALV PIPE
 1 - 2" VALVE
 1 - VALVE BOX

LESLIE & SHAW
 TO
 CITY OF GREENVILLE

1" = 100'
 Original Value = 465' @ 0.80 = \$ 372.00
 Less Depreciation ~~0.20~~ = 99.20
 Value at present \$ 272.80 (Am. 59¢/ft)

Recorded May 4, 1964 At 2:48 P.M. # 31096