


5297A
1393-A

1.08

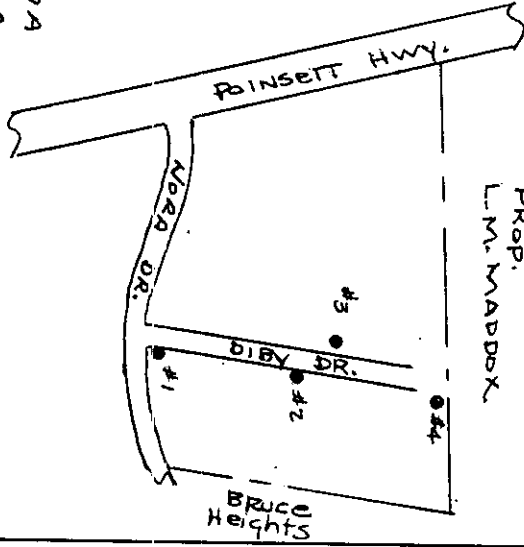

Name and Post Office Address of Grantor: W.M. BATSON
1218 Binsett Hwy
Greenville, S.C.

Toll Line (Name) _____
 Or _____
 Exchange Line (Name) Greenville S.C.
 Tributary to _____ (Exchange)

The Property is bounded where the line enters and leaves this property by the property of:
NORA DRIVE on the S and _____ on the _____ and _____

The poles (or stakes) have the following identification: # 1 to # 4

Authority: 43-1531 Classification 1-C
 Area: Greenville S.C.
 Approved: W.M. Batson
 Title: Original Grant

GEP 47.101

GENERAL PERMIT

34379 (INDIVIDUAL) Form 8418 Nov. 54

Received of the SOUTHERN BELL TELEPHONE AND TELEGRAPH COMPANY ONE AND NO/100 Dollars in consideration of which (I) (we) hereby grant said Company, its associated and allied companies, their respective licensees, successors and assigns, the right to construct, operate and maintain a line of communication consisting of such poles, wires, cables, conduits, guys, anchors and other necessary appurtenances as from time to time are required upon, across, over and/or under that certain tract of land situated in Greenville County, State of South Carolina, to-wit: THAT TRACT of land lying north of Nora Drive and bounded on the West by the Binsett Highway and on the north by L.M. MADDOK and on the east by Bruce Heights. and upon, along and under the roads, streets, or highways adjoining or through said property with the right to permit the attachment of and/or carry in conduit wires and cables of any other person or company for communications purposes or for the transmission and distribution of electric power and the right of ingress and egress to said premises at all times for the purpose of inspecting and maintaining said line and with the right to clear and keep cleared all trees, undergrowth or other obstructions within a strip of land (Eight) feet on each side of the center of said line and to trim and cut and keep trimmed and cut all dead, weak, leaning or dangerous trees which might reach said line in falling; including the right to relocate said line on said premises to conform to any future highway relocation, widening or improvement; the said sum being received in full payment for the rights herein granted.

Signed, sealed and delivered in the presence of:
John H. Ferguson
Truman H. Dickson

Executed MAY 28TH, 1964
W.M. Batson (SEAL)
W.M. BATSON (SEAL)

GEP 47.101

ACKNOWLEDGMENTS For Use in South Carolina

Individual Form

STATE OF SOUTH CAROLINA }
COUNTY OF GREENVILLE } SS.

Personally appeared before me John H. Ferguson
 and made oath that (he) (she), with Truman H. Dickson saw the within named W.M. Batson
 sign, seal, and deliver as (his) (her) (their) act and deed the within written instrument, and that (he) (she) with the said Truman H. Dickson witnessed the execution thereof.

Sworn to before me this 28 day of May, A.D. 1964
John H. Ferguson
 Notary Public

Right of way Recorded June 3, 1964 At 4:56 P.M. # 34379

GREENVILLE CO. S.C.
 Form 8428 Nov. '54
 JUL 3 4 56 PM 1964
 OFFICE OF THE CLERK OF COURTS
 GREENVILLE, S.C.