



PIEDMONT NATURAL GAS CO. INC.

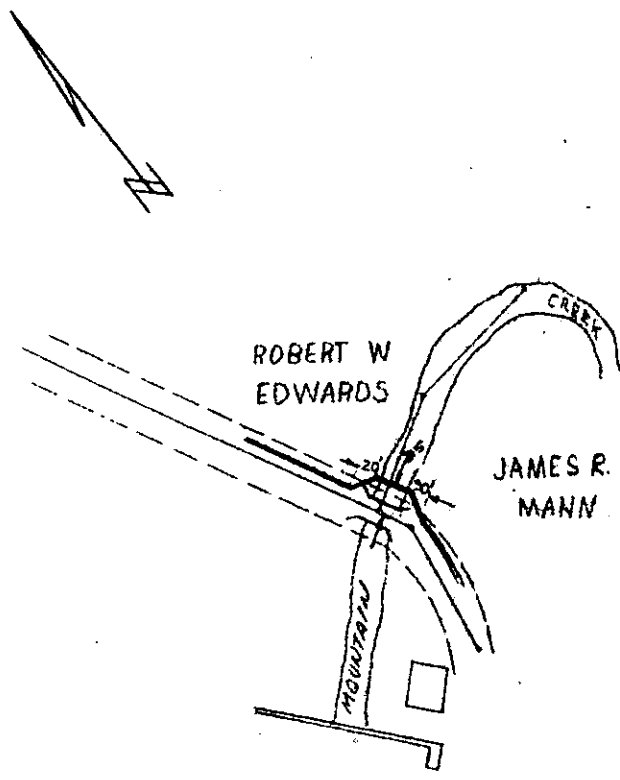

SCALE 1"=100'

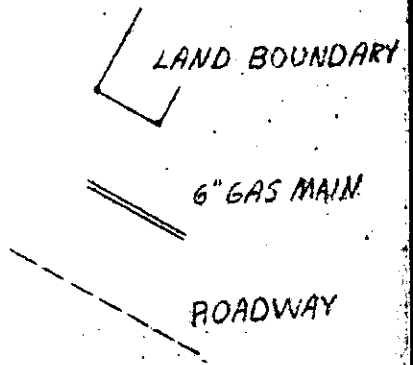

Recorded June 24th., 1965 At 9:55 A.M. # 36067