
BOCK, 799 PAGE 355

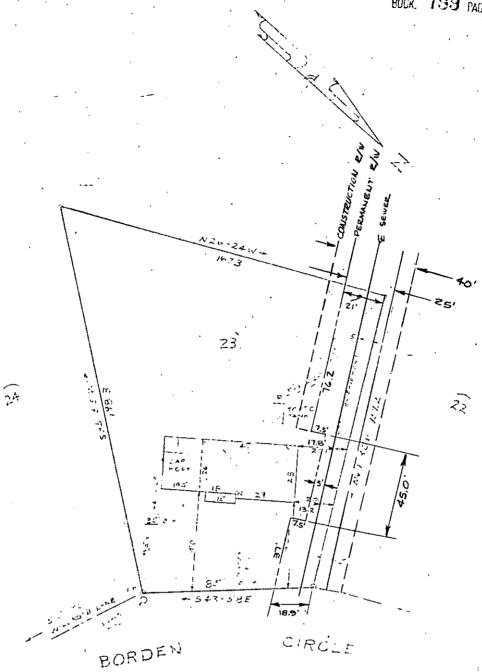

I hereby certify that on Dec. 17, 1962 I surveyed lot 23 of Surny Acres according to a plat by C.C. Jones dated Aug, 1961 and recorded in plat book "XX" on page 5in the R.M. C. office for Greenville County; and that the property lines buildings and wells are as shown hereon, that no walls or buildings on this property encroach or project on adjacent streets or property, and that no adjacent swellsnor buildings encroach or profect on these premises.

PROPERTY OF BOYD V. TOLLISCN

NEAR THE STY OF GPEET VILLE GREENVILLE COUNTY SC

WESS SURVEYING EMAPPING CO

SCALE 1'=40'

DEC. 17, 1952

Charles F. Webb R.L.S. 1577

Recorded June 1st., 1966 A t 10:06 A.M. # 34204