


B.B. MIS 2-2-2

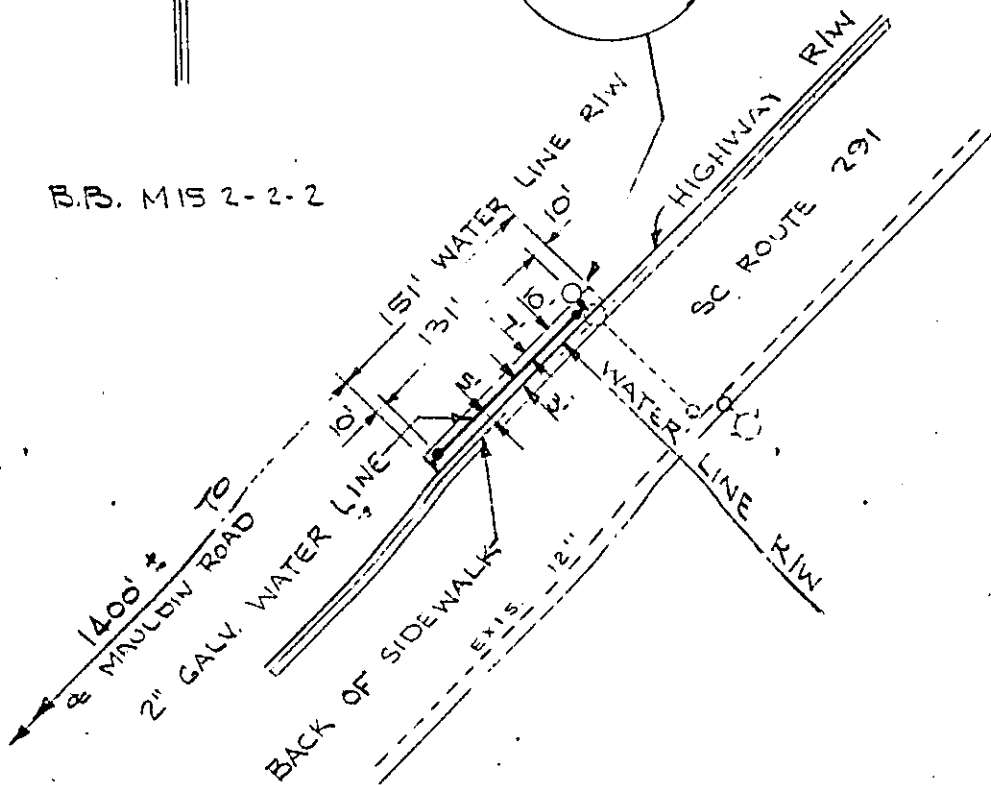

MATERIAL LIST

|       |   |                    |
|-------|---|--------------------|
| 1     | - | 6' X 6' M.J. Cross |
| 1     | - | 6' M.J. Gate Valve |
| 2     | - | 2" Gate Valves     |
| 131'± | - | 2" Galv. Pipe      |
| 8'    | - | 6" C.I. Pipe       |

Mrs. Sue C. Ashmore

TO

City of Greenville, S.C.

Scale 1" = 100' - October 1967

Recorded November 6, 1967 At 4:41 P.M. # 13250