


MATERIAL LIST:

- 1662 ft. ± 6" C.I. Pipe
- 1600 ft. ± 3" Galv. Pipe
- 1200 ft. ± 2" Galv. Pipe
- 2 - 6" Valves
- 1 - 3" Valve
- 2 - 2" Valves

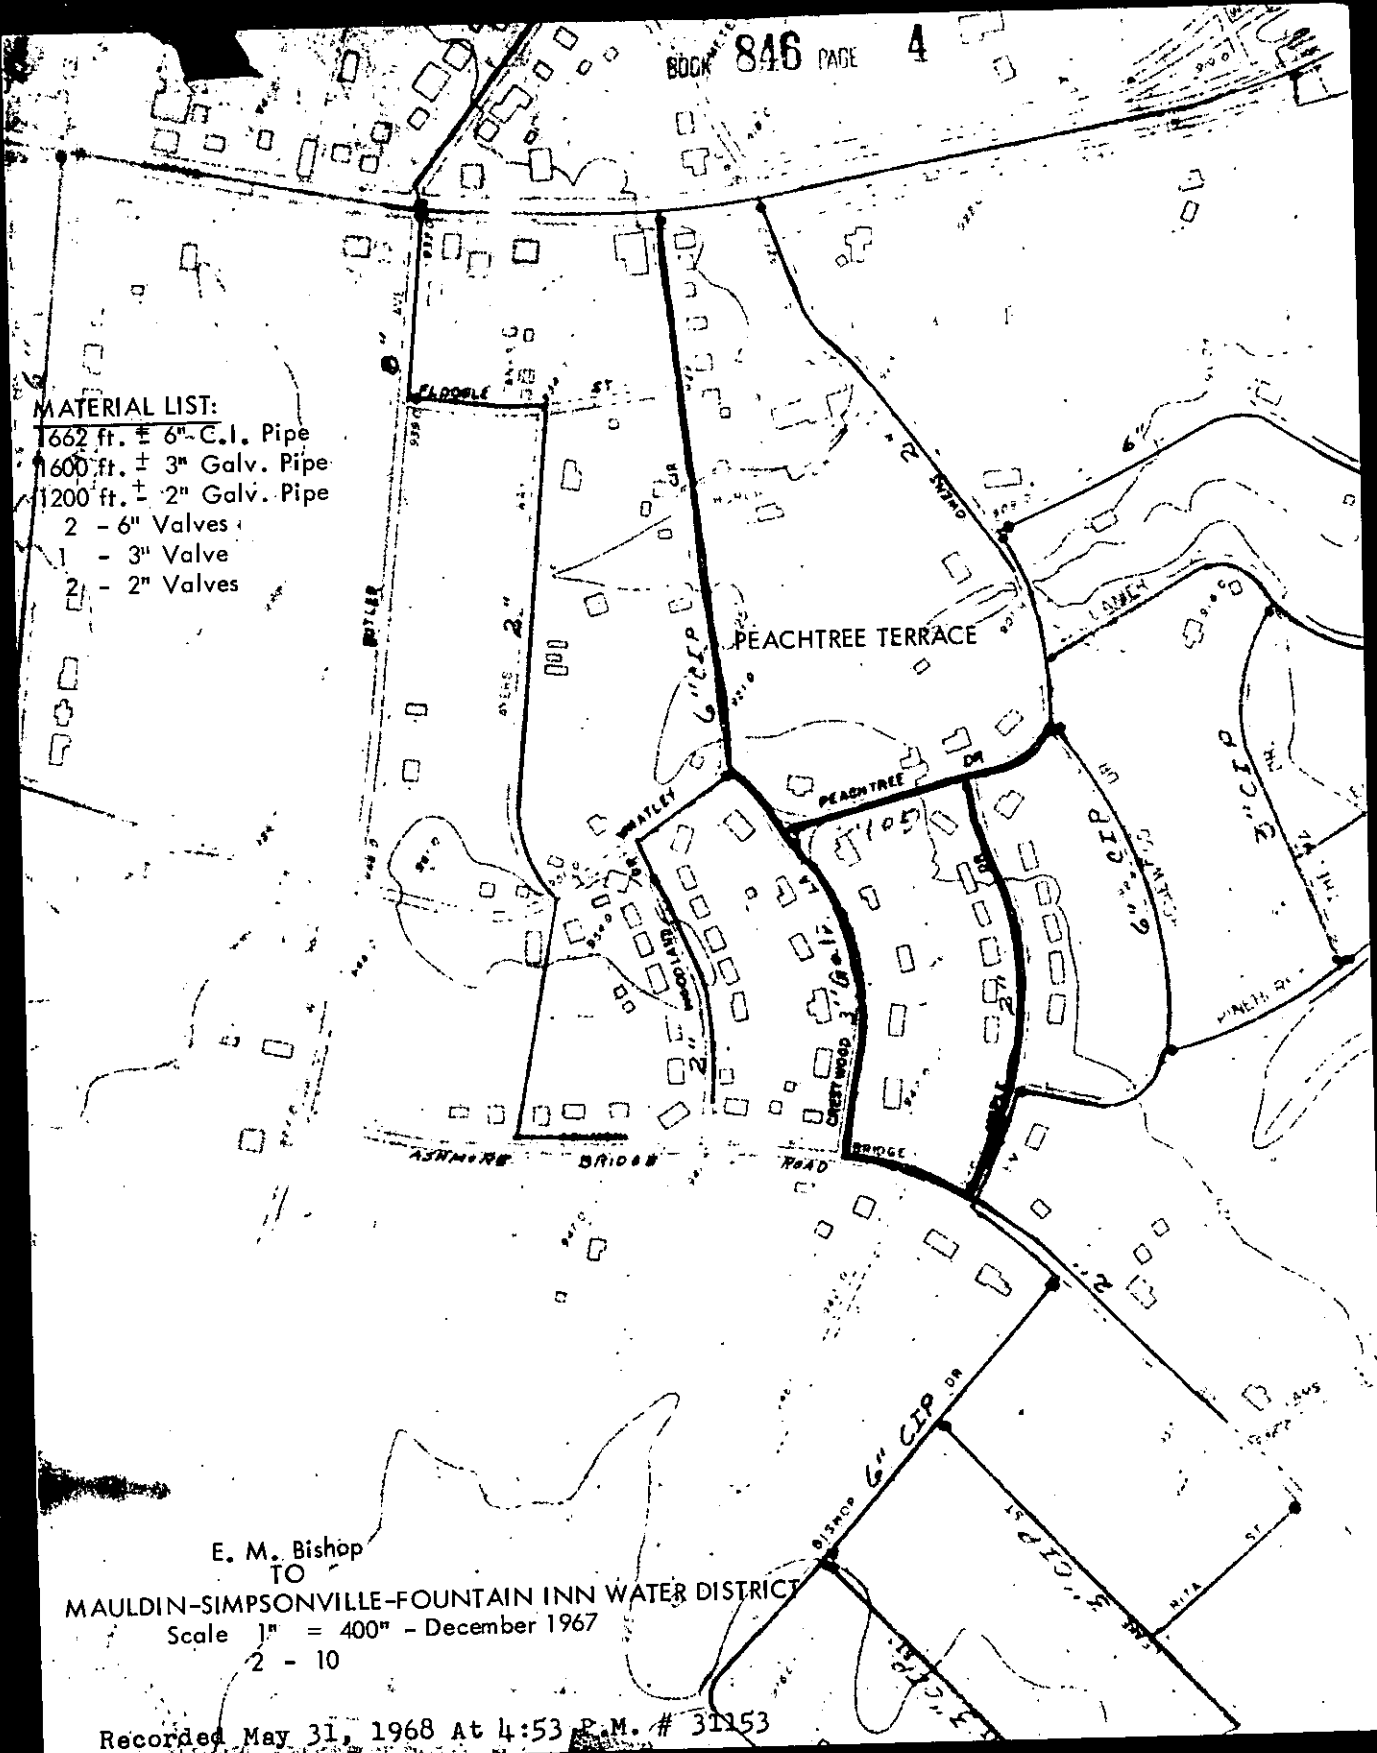

E. M. Bishop
 TO
 MAULDIN-SIMPSONVILLE-FOUNTAIN INN WATER DISTRICT
 Scale 1" = 400' - December 1967
 2 - 10

Recorded May 31, 1968 At 4:53 P.M. # 31153