


- MATERIAL LIST:  
 4,015 ft. ± - 6" Cast Iron Pipe  
 4 - 6" Valves  
 1 - 4" Valve  
 1200 Ft. ± - 2" Galv. Pipe  
 1 - 2" Valve

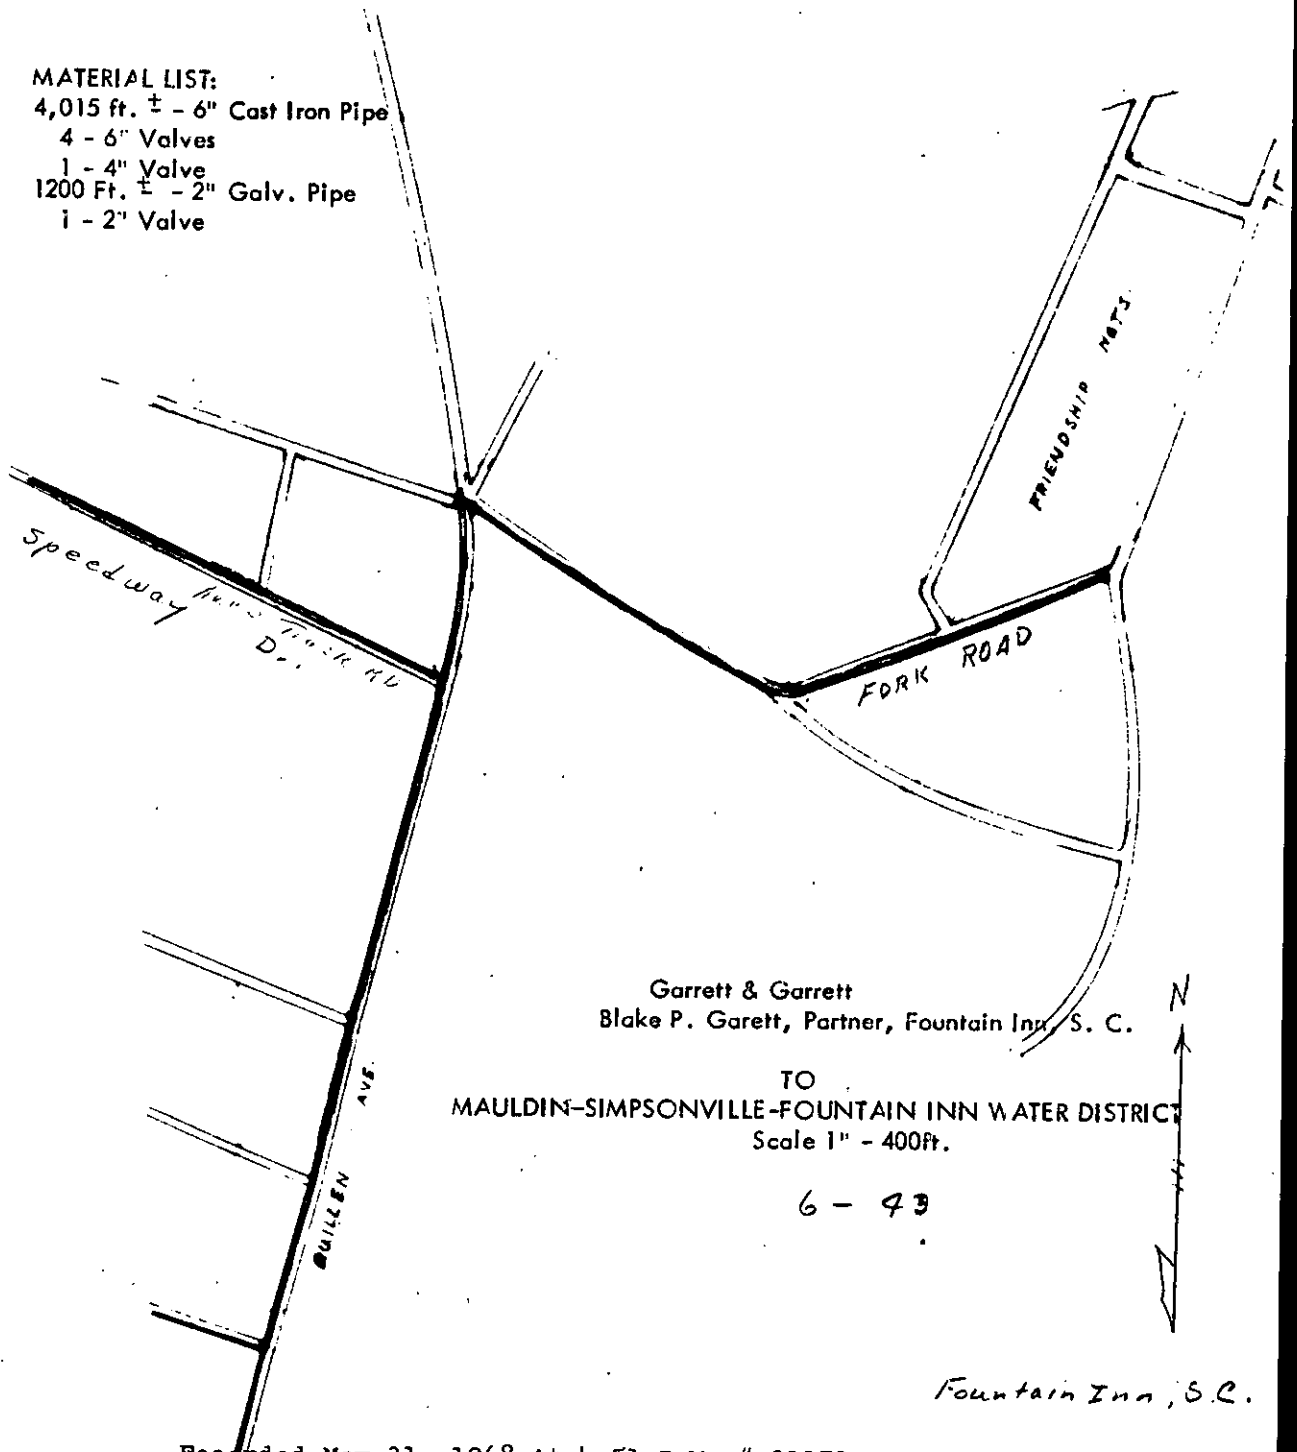

Garrett & Garrett  
 Blake P. Garrett, Partner, Fountain Inn, S. C.

TO  
 MAULDIN-SIMPSONVILLE-FOUNTAIN INN WATER DISTRICT  
 Scale 1" - 400ft.

6-43

Fountain Inn, S.C.

Recorded May 31, 1968 At 4:51 P.M. # 31173