




GREENVILLE APARTMENTS

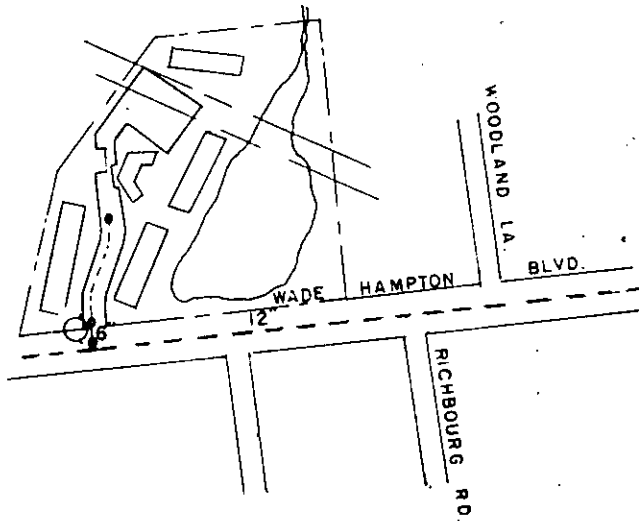

MATERIAL LIST

- 78' ± of 6" C. I. Pipe
- 2 - 6' Valves
- 1 - Fire Hydrant

Walter J. Kussana
 to
 Wade Hampton Water & Sewer District
 Scale 1" = 40'
 October, 1968

Recorded December 31, 1968 At 4:55 P.M. # 15646