


Plat 810

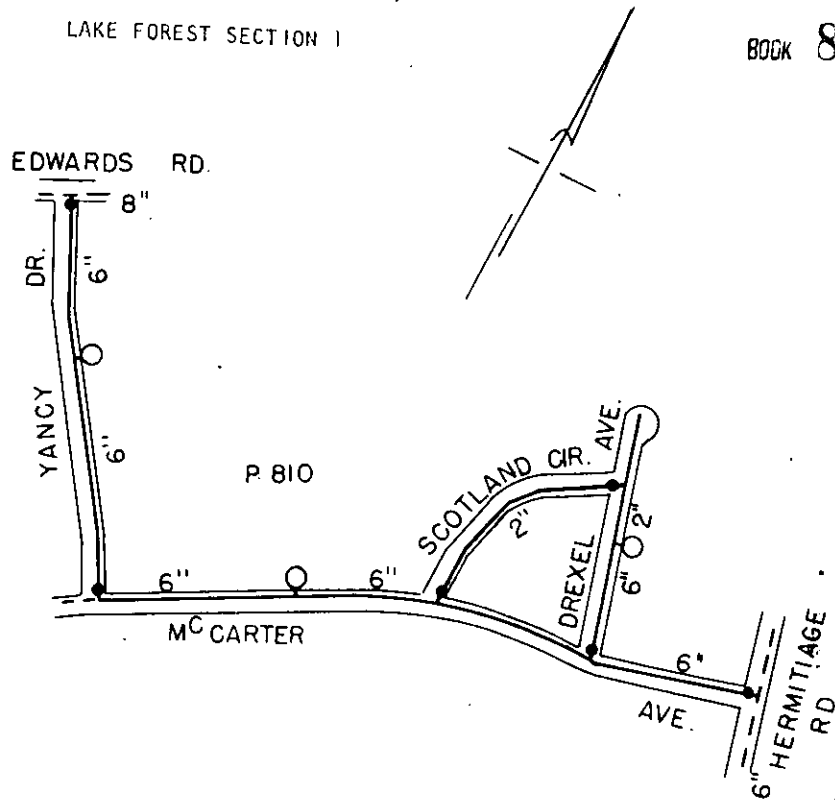

MATERIAL LIST

- 3,000'± - 6" C.I. Pipe
- 1,040'± - 2" Galv. Pipe
- 7 - 6" Valves
- 2 - 2" Valves
- 3 - Fire Hydrants

T.A. McCarter, Agent
 Wade Hampton Water & Sewer District

Scale 1" = 400', June 1968

Recorded December 31, 1968 At 4:55 P.M. # 15651