


9.47 Ac.

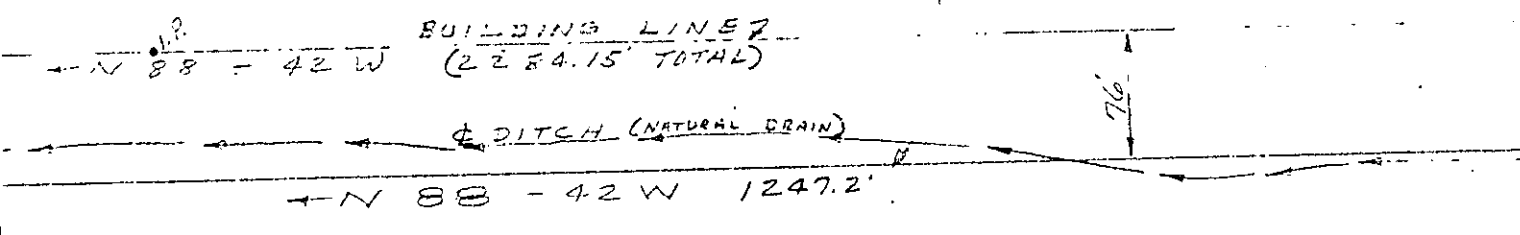

N 88° - 42' W
E-W. RUNWAY

PROPERTY OF
LLE MUNICIPAL AIRPORT
GREENVILLE, S.C.

REVISION
9.47 Acre Tract Add
March 23, 1965

MARCH 11, 1965 SCALE: 1" = 100'