


Scale: 1" = 400'

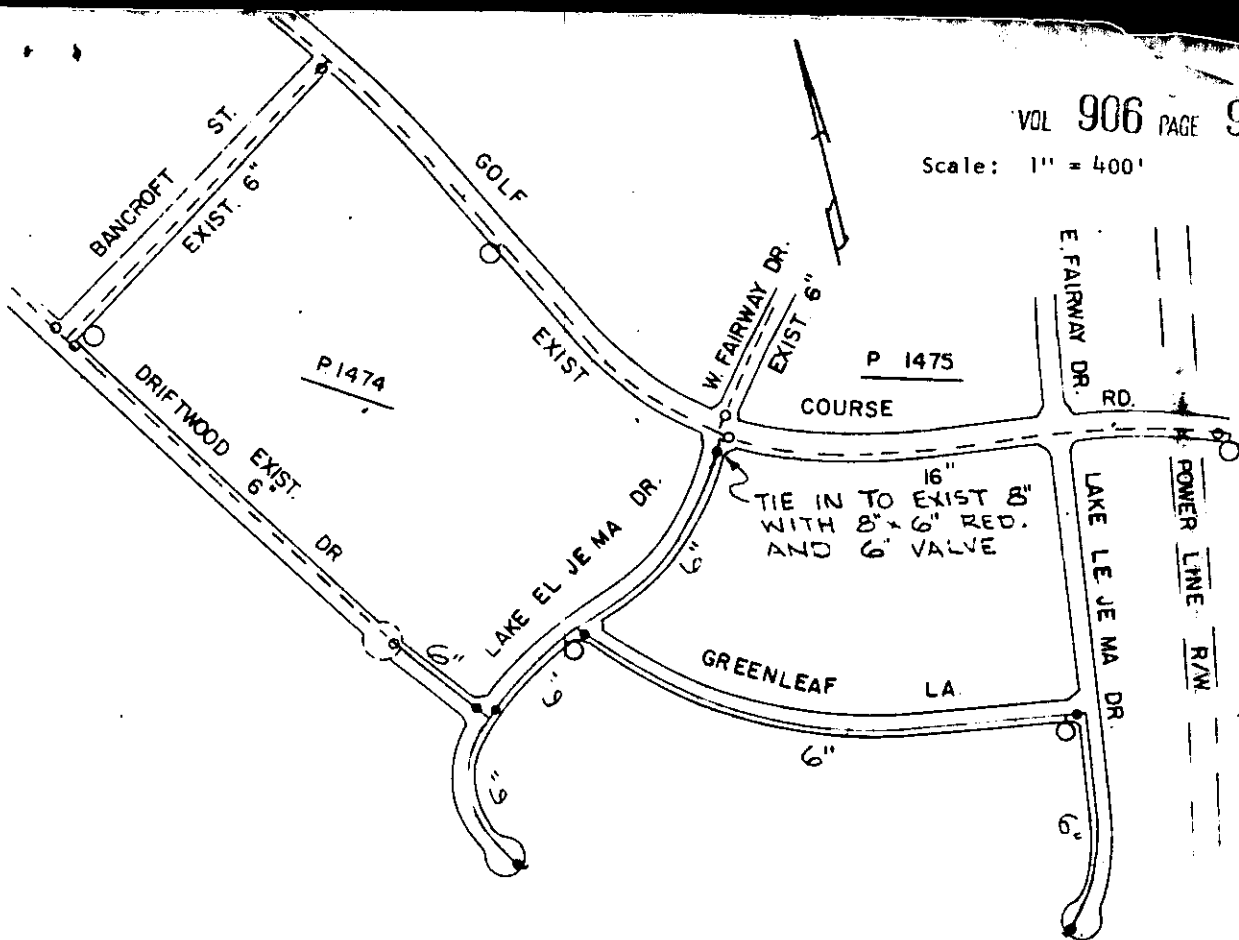

Material List

- 3,580' - 6" C. I.
- 7 - 6" Valves
- 2 - 2" Valves
- 2 - Hydrant

Belle Terre Acres
Section No. 2

J. W. Mahon
to
Greenville Water Works
June, 1969

Recorded January 8, 1971 At 12:13 P.M. # 15759