VOL 907 PAGE 77

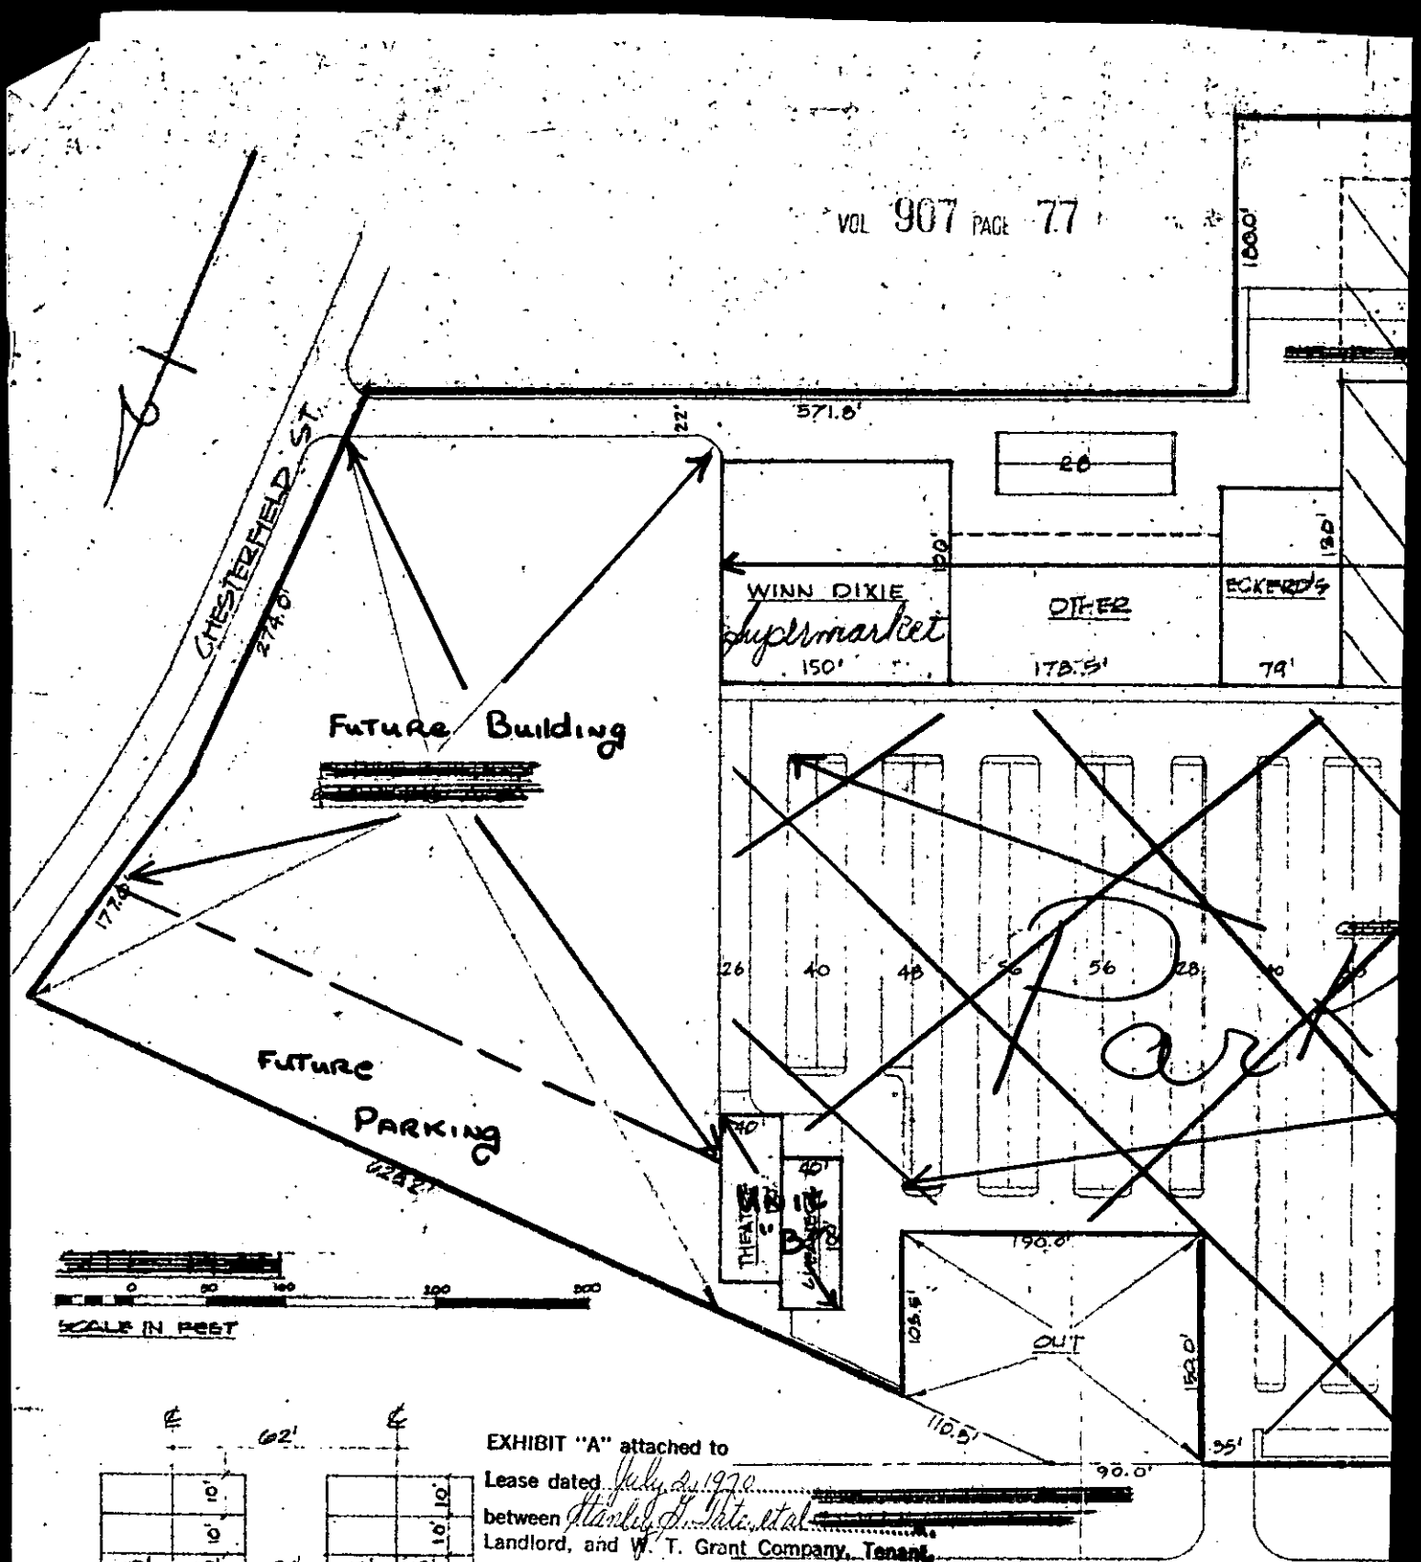

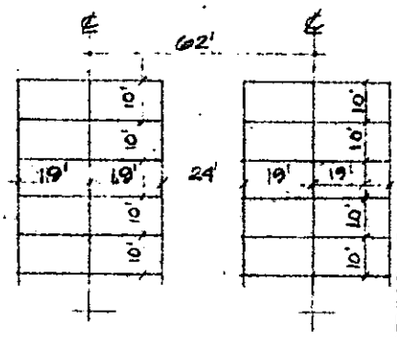

EXHIBIT "A" attached to
Lease dated July 2, 1970
between Stanley G. Tate, et al
Landlord, and W. T. Grant Company, Tenant.

APPROVED ..... 19 .....
Landlord
By (See below)

APPROVED Nov. 10, 1970
Tenant
By James C. Nicholson, Atty.

U.S. HIGH

(Continued on Next Page)