


WEST-
SATED
ROOF

VOL 908 PAGE 99

(Continued on next page)

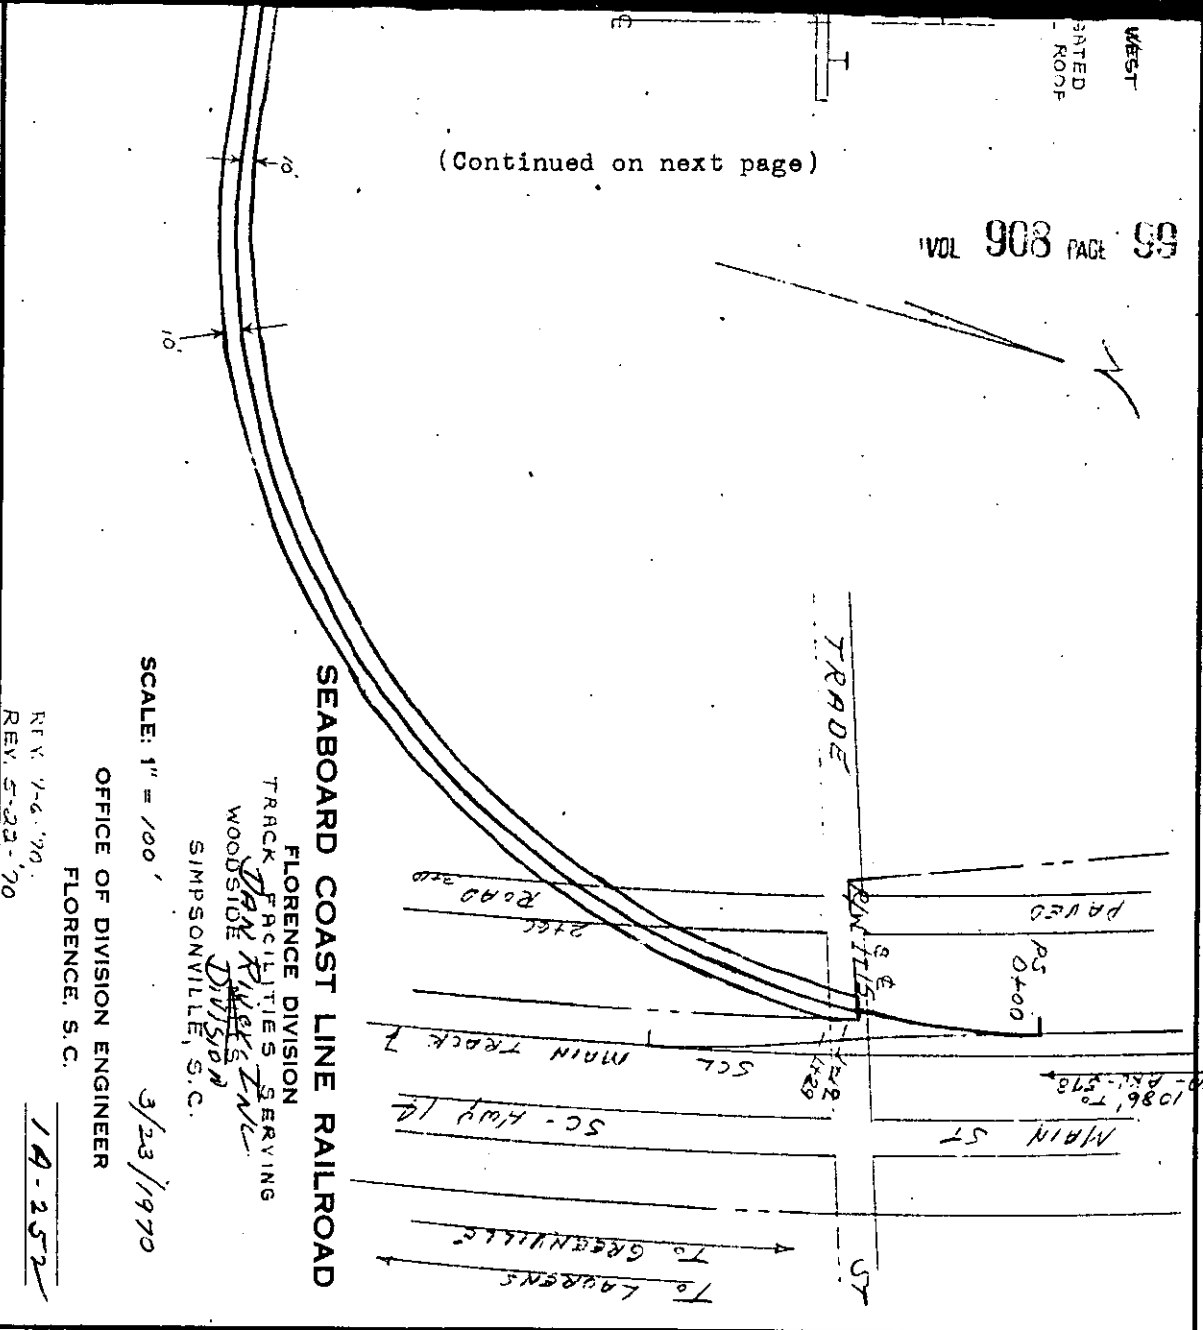

SEABOARD COAST LINE RAILROAD

FLORENCE DIVISION
TRACK FACILITIES SERVING
WOODSIDE DIVISION
SIMPSONVILLE, S.C.

SCALE: 1" = 100' 3/23/1970

OFFICE OF DIVISION ENGINEER
FLORENCE, S.C.

REV. 7-6-'70
REV. 5-22-'70

19-252

Recorded February 4, 1971 At 2:42 P.M. # 18141