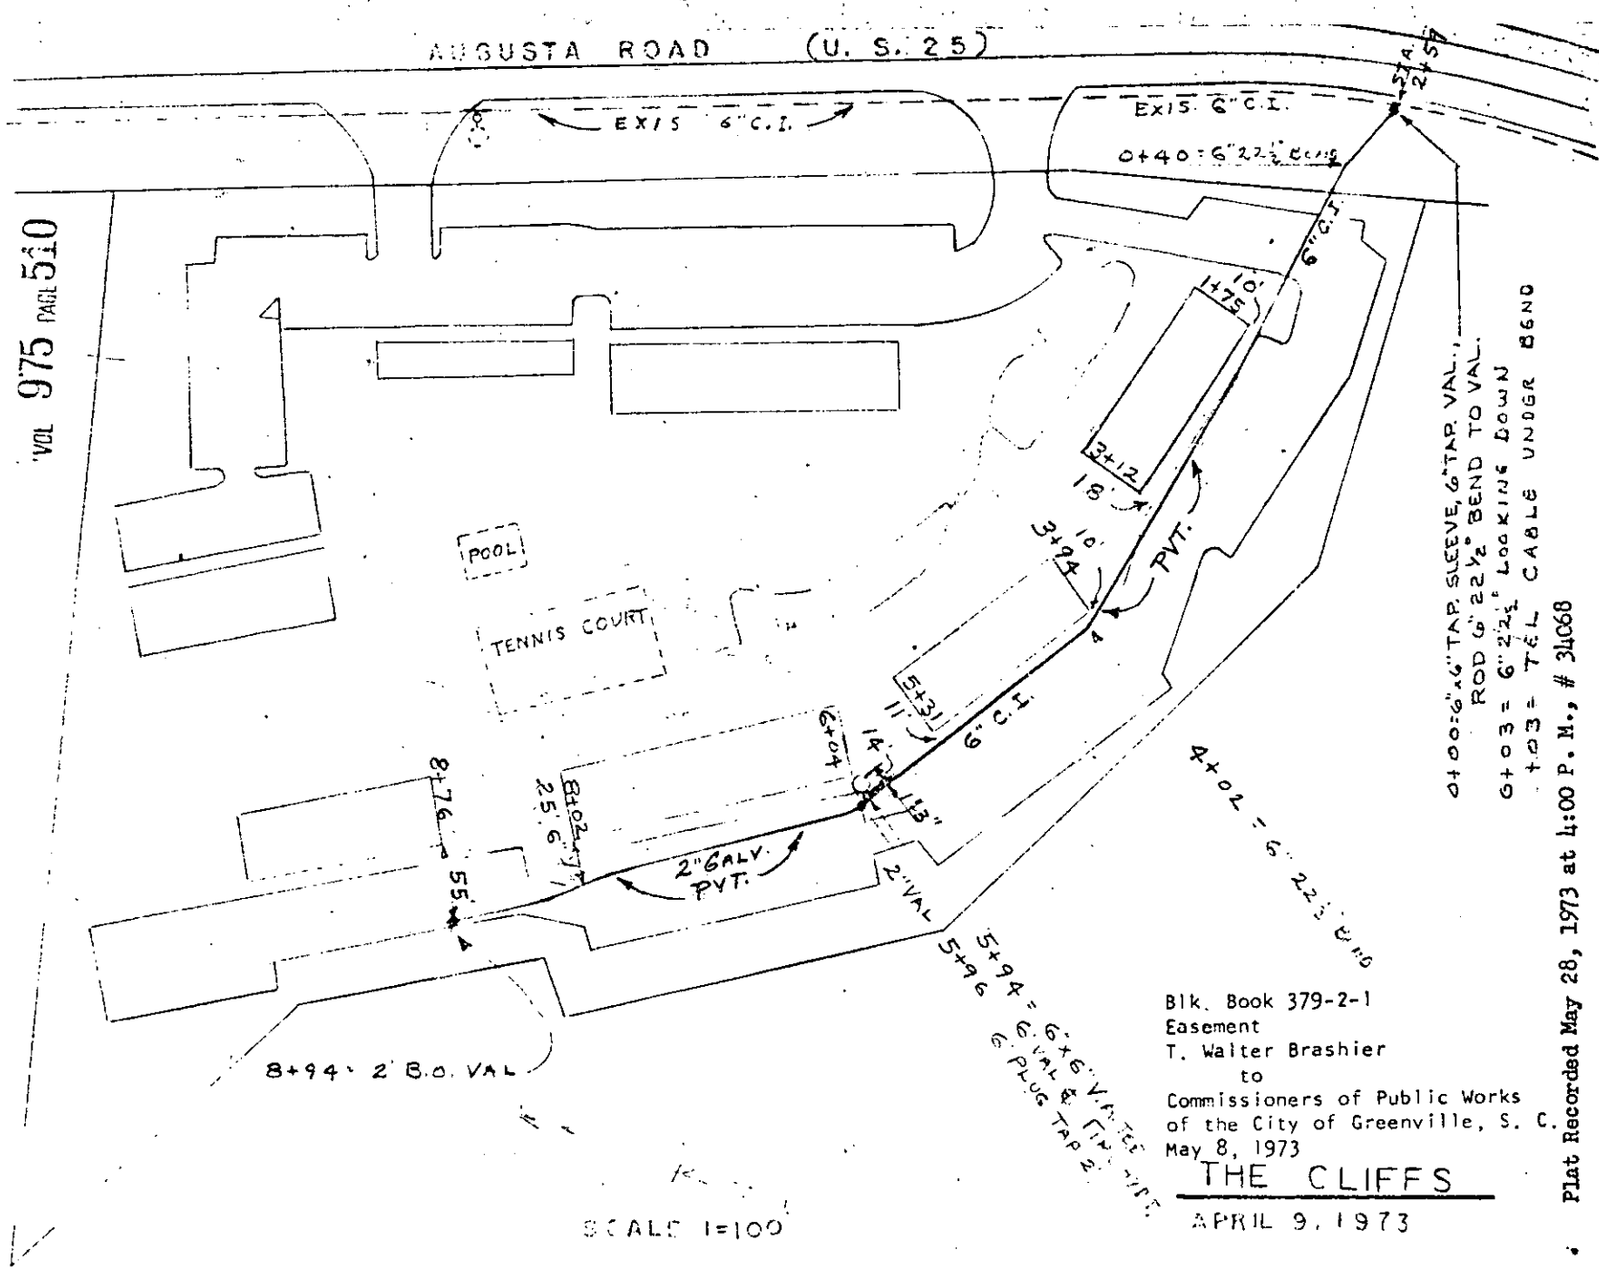

Blk. Book 379-2-1
Easement
T. Walter Brashier
to
Commissioners of Public Works
of the City of Greenville, S. C.
May 8, 1973

THE CLIFFS

APRIL 9, 1973

Plat Recorded May 28, 1973 at 4:00 P. M., # 31068