


SCALE 1" = 400'

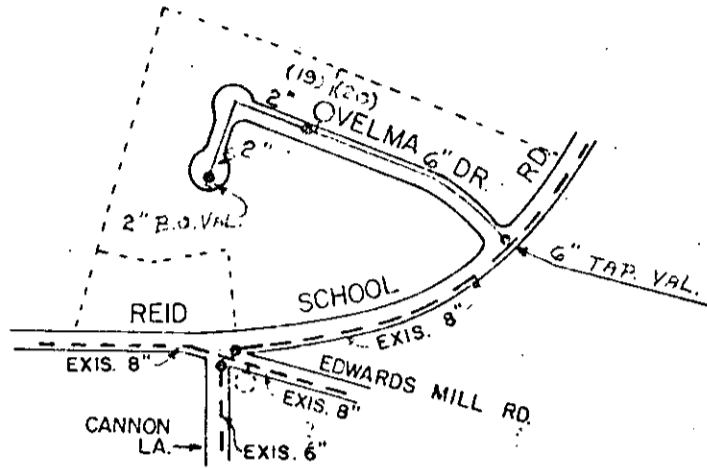

TAYLOR HEIGHTS SUBD.

APRIL, 1972 (PT. BLK. B. T27-1-7)

Material List:

6" C. I. Pipe	-	585'±
2" Galv. Pipe	-	450'±
6" Valves	-	2
2" Valves	-	2
Fire Hydrant	-	1

Alvin Trammell;
 to
 Commissioners of Public Works
 of the City of Greenville, S. C.
 April 20, 1973

Plat Recorded June 14, 1973 at 10:16 A. M., # 36095