



B 2 4 0

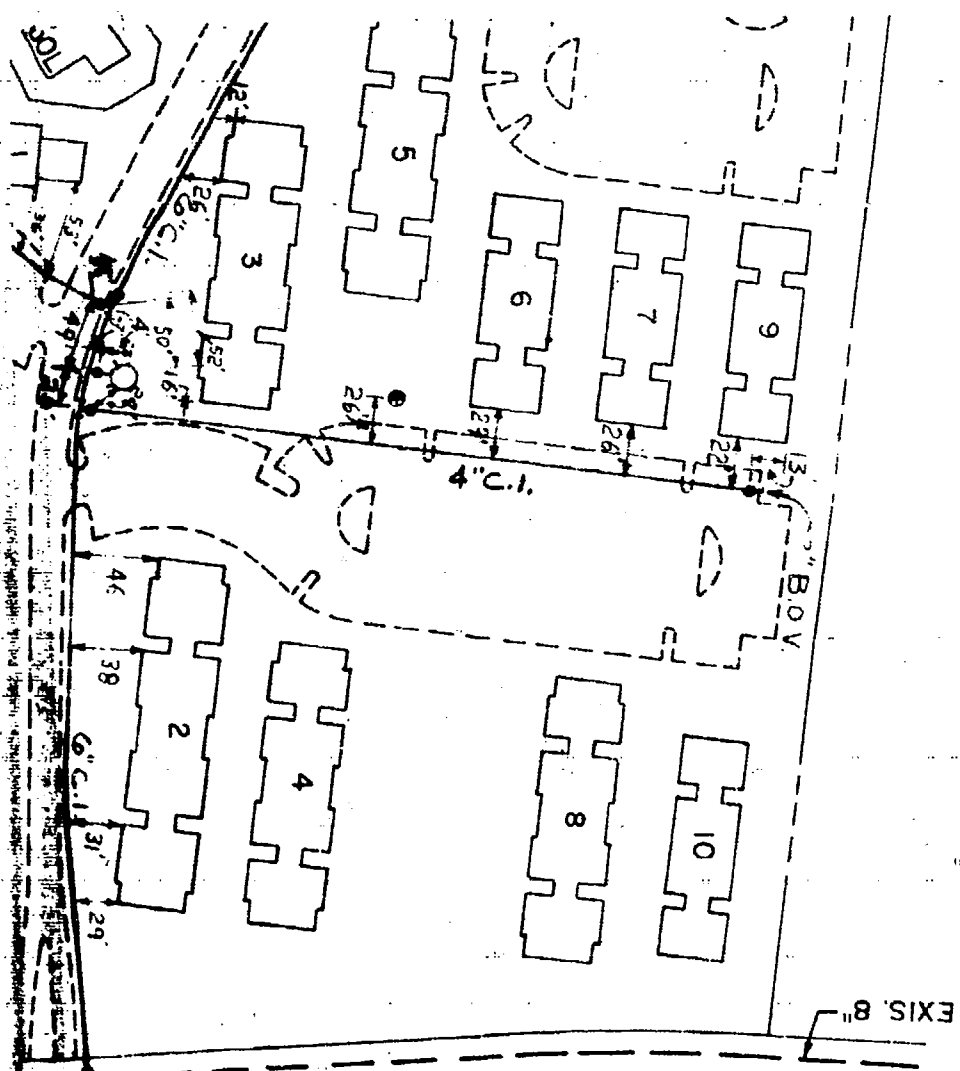

VCL 988 PAGE 429

SCALE 1"=100'

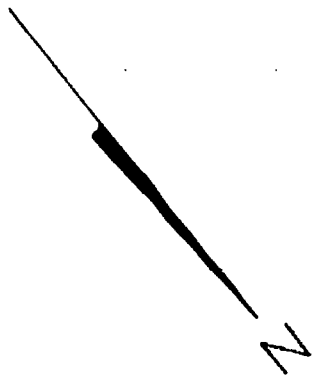

8" TAPPING SLEEVE
6" TAPPING VAL.

CEDAR

EXIS. 8"

Deed and Plat Recorded October 19th, 1973 at 10:49 A.M. #10932

4328. MW. 2
8234