




VCL 986 FAC: 478

0478

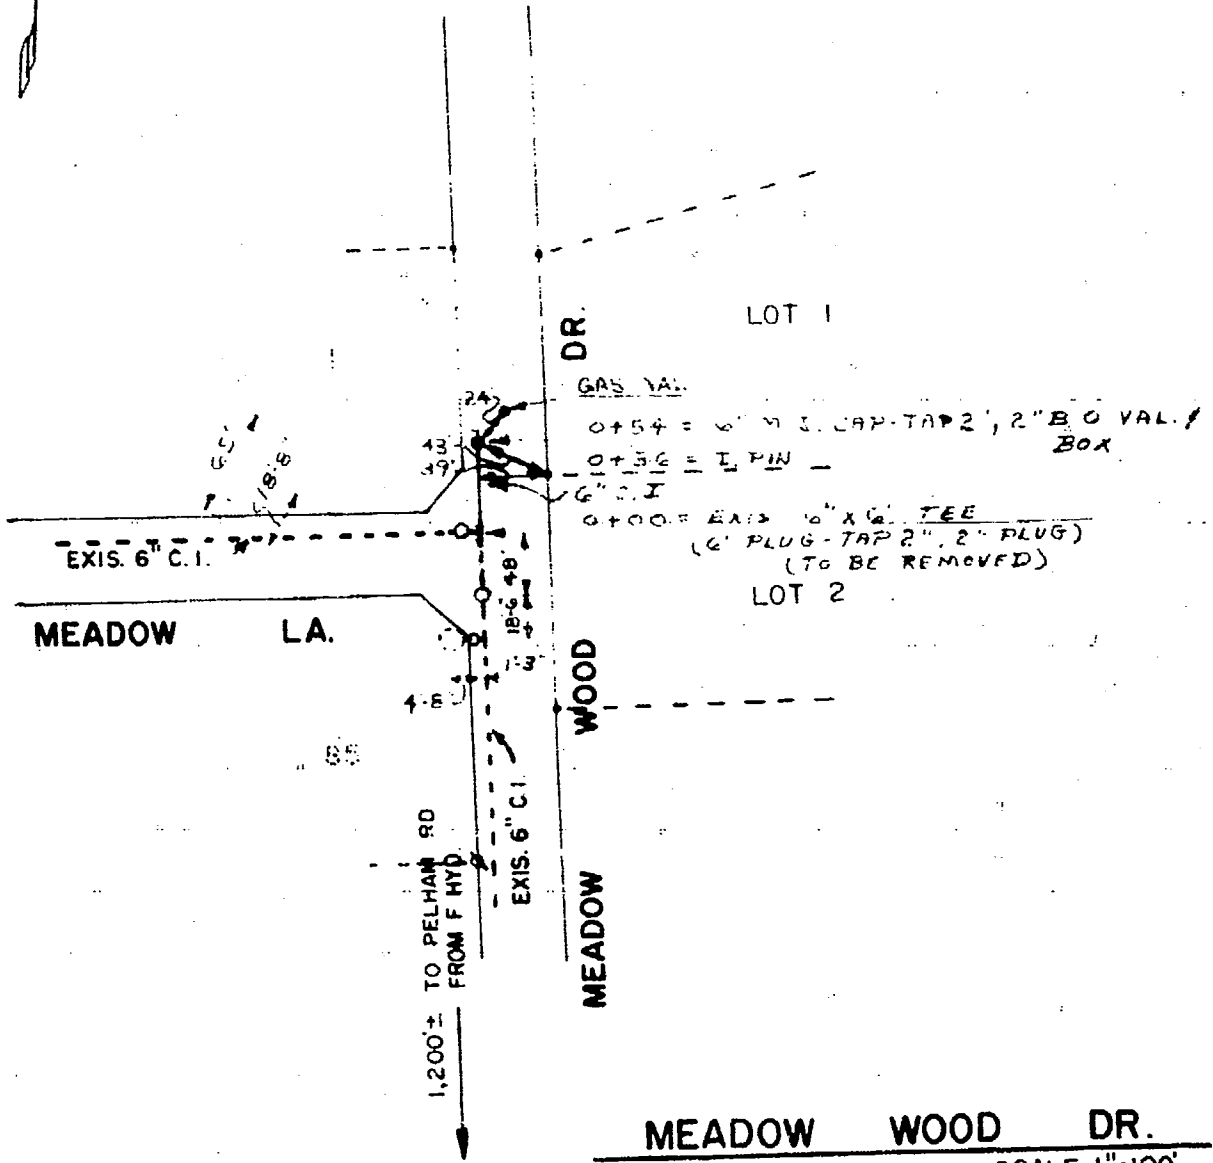

Material List.

6" C. I. Pipe	-	54'
2" Valve	-	1

MEADOW WOOD DR.
 SEPT., 1973 SCALE 1"=100'

Cottrill & Darby Builders, Inc.
 & M. G. Proffitt, Inc.
 to
 Commissioners of Public Works
 of the City of Greenville, S. C.
 October 2, 1973

Deed and Plat Recorded October 19th, 1973 at 10:19 A.M. #10931

4328 W. 2