"EXHIBIT A"

VOL 996 PAGE 79

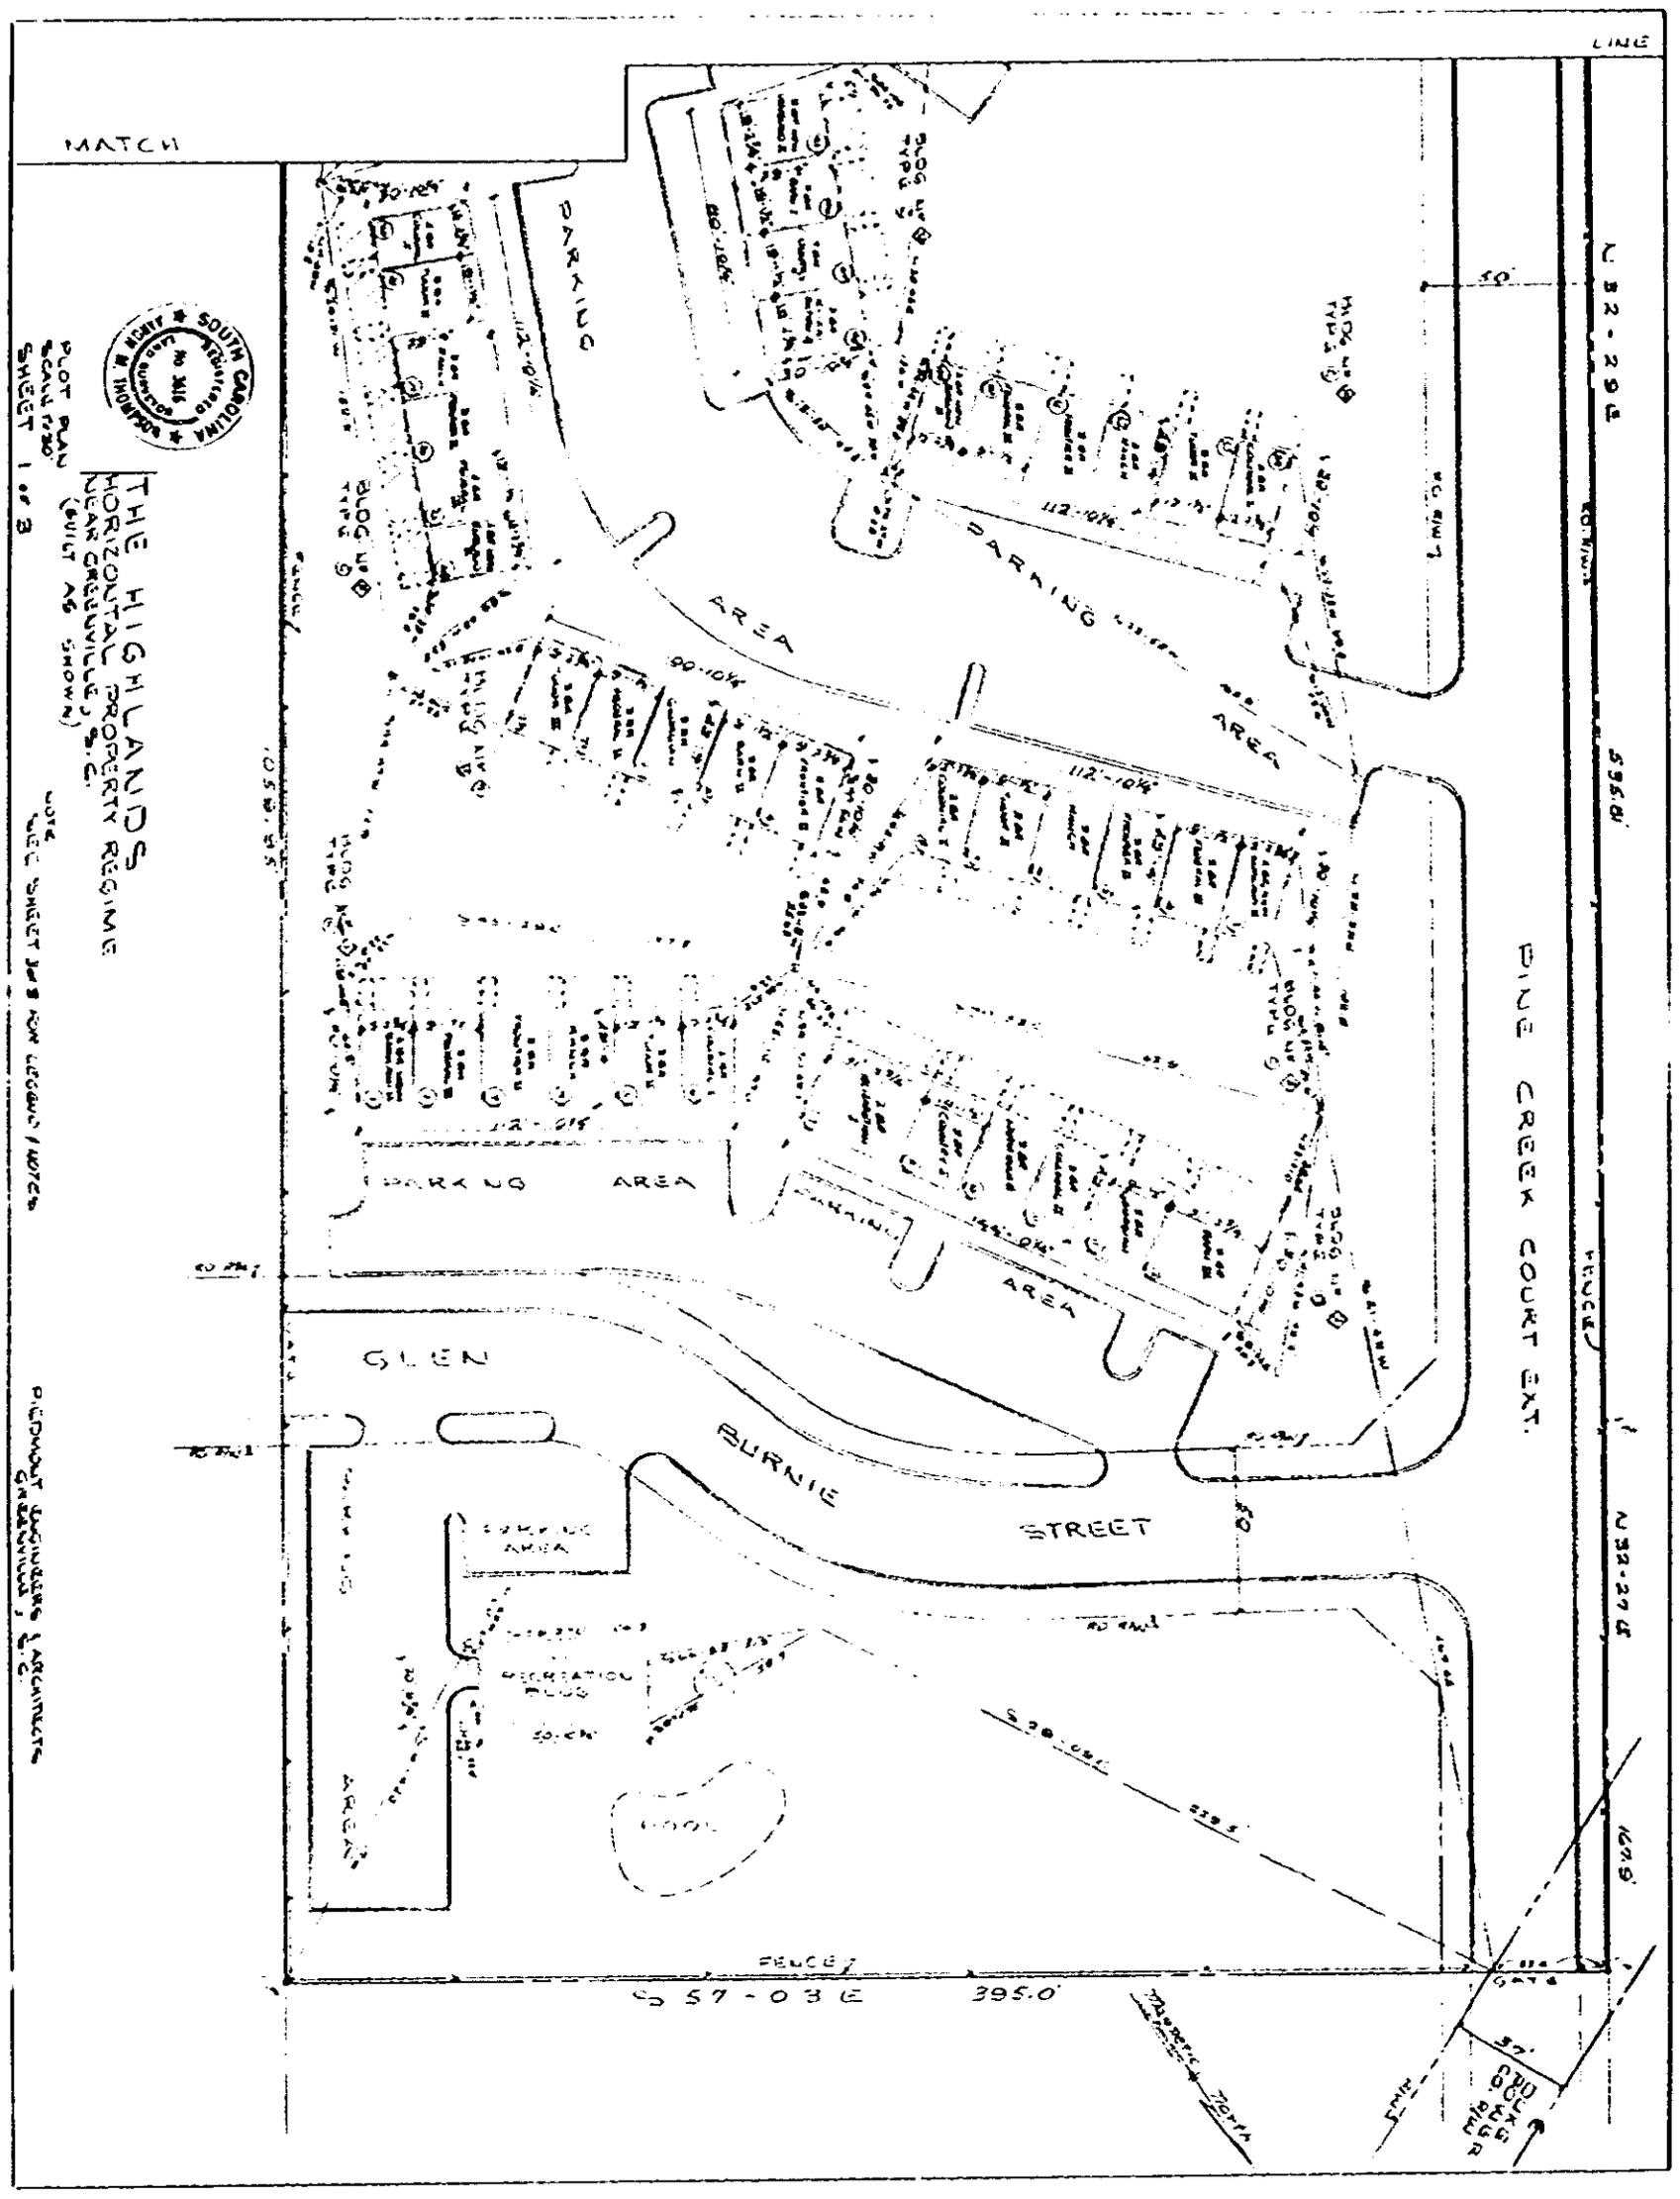

RECORDED
4328 RV.2