

Name and Post Office Address of Grantor Margaret R. Whaley
107 St. Augustine
Greenville, South Carolina

Toll Line _____ (Name)
 or Exchange Line Woodruff Road Wire Center
 tributary to _____ (Exchange)


The Property is bounded where the line enters and leaves this property by the property of:
Providence Square (St) on the North
 and Mary B. Childress on the West

Authority S-8346 Classification 945C
 Area Greenville, South Carolina

Approved _____
 Title District Engineer

1700
 7608

1000

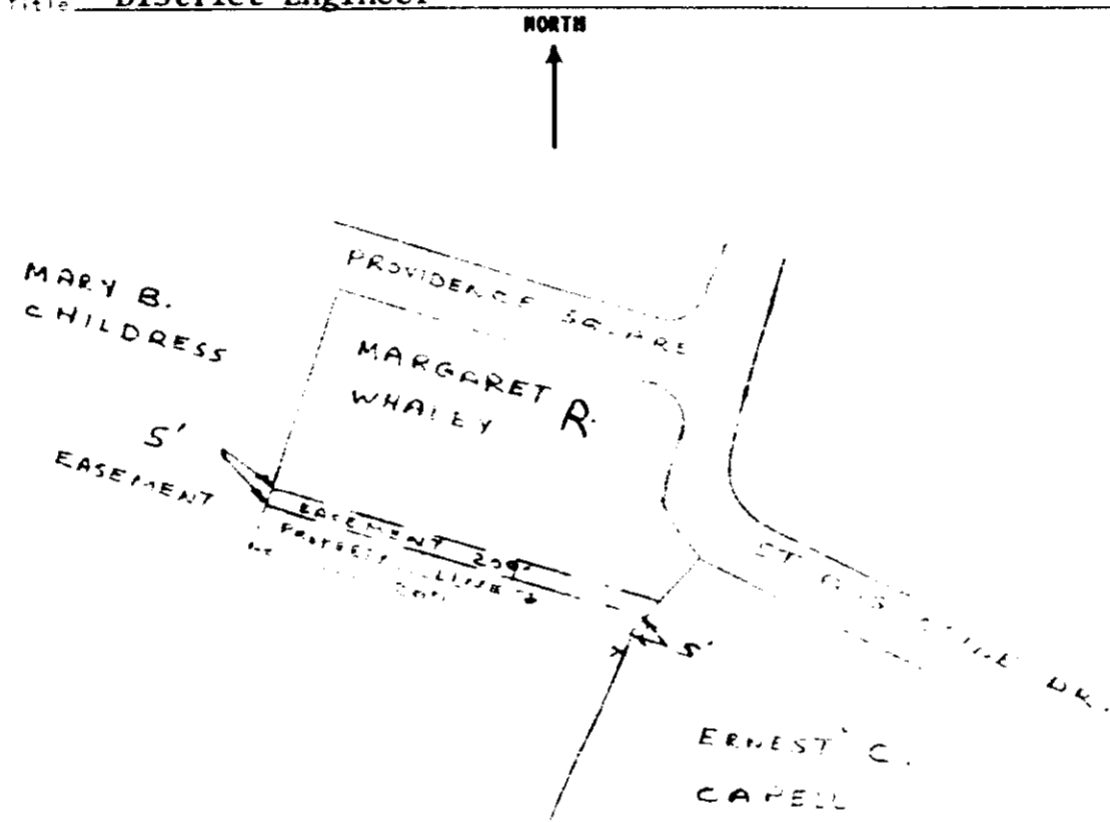

RECORDED SEP 17 '76 At 1:38 P.M.

7608
 Filed for record in the office of
 the R. M. C. for Greenville
 county, S. C. at 1:38 o'clock
 P. M. Sept. 17, 1976
 and recorded in Deed Book
 1043 at page 64

R. M. C. F. C. Co. S. C.

4328 RV-2