


ELLIE F. BROOKSHIRE
REF: DWG. NO. 22-155

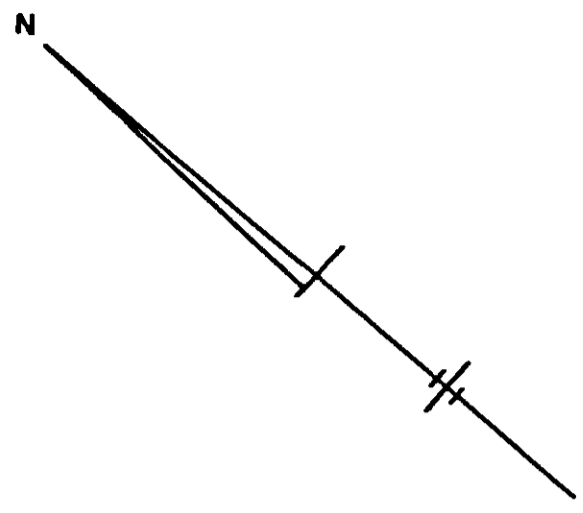

E. IS E. FAIRVIEW DRIVE
(BLACKTOP)

0.51 ACRE
DEEDED TO
ROSE R. PETTY

C. H. RAINEY
REF: DWG NO. 24-23

LILLIE PITTMAN
LILLIE PITTMAN
LILLIE PITTMAN

GEORGE MATTHEWS
1.12 ACRES
WILMA CHILDRESS
1.98 ACRES
LOWEE C. HAMBY
REF: DWG. NO. 22-160

MARION L. BEECO
REF: DWG. NO. 22-72

NOTE: REVISED 12-9-63
0.51 ACRE TRACT TO
BE DEEDED TO ROSE R.
PETTY ADDED 9-15-76

DUKE POWER COMPANY
TIGER - NORTH GREENVILLE
TRANSMISSION LOT
ACQUIRED FROM
LILLIE PITTMAN
NEAR GREENVILLE, S.C.
CHICK SPRINGS TOWNSHIP
GREENVILLE COUNTY

SCALE: 1" = 200'
BOOK NO. 659
JULY 9, 1963
FILE NO. 23-95

4328 RV.2J

0657