


LIMITED COMMON ELEMENTS

Exhibit A

VOL 1035 PAGE 235

FOUNDATION PLAN

CURTAIN WALL

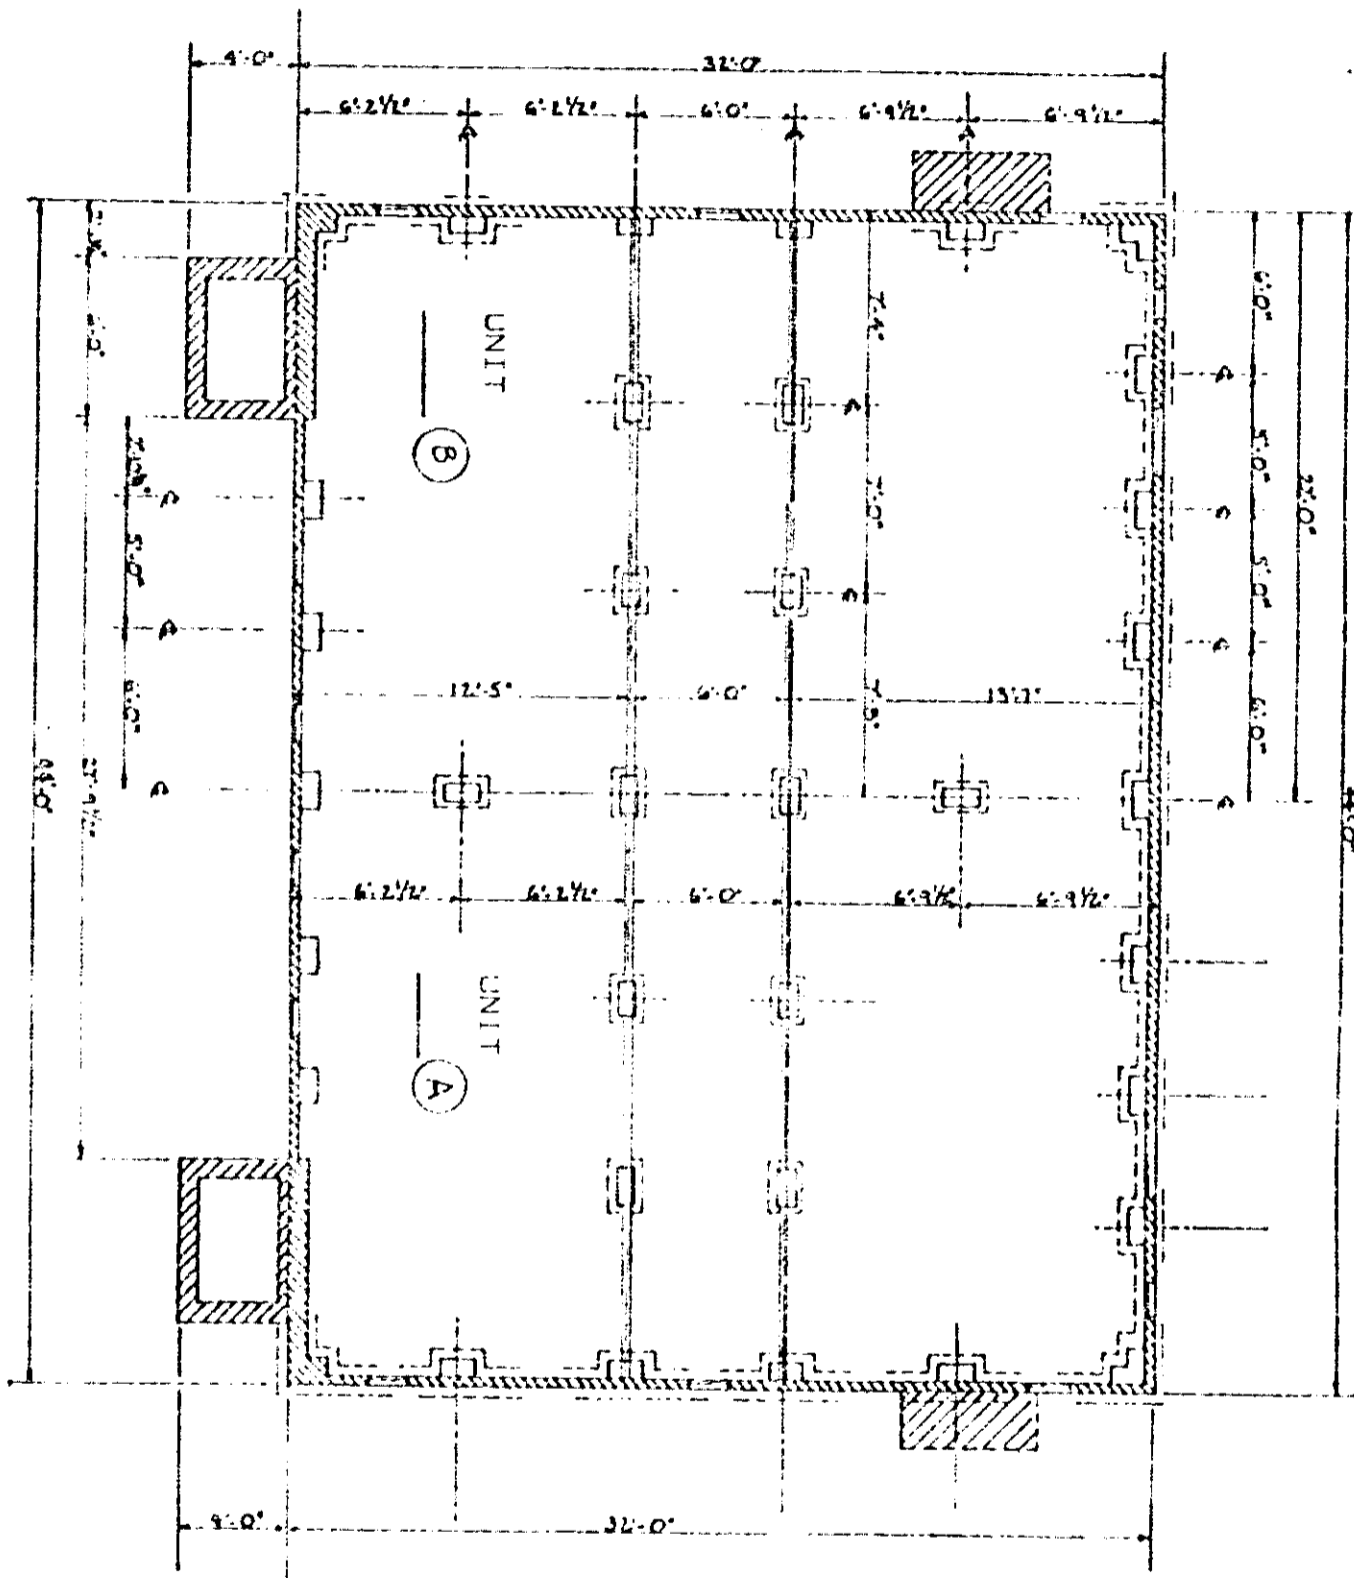

CERTIFICATE

I, Wade H. Barber, do hereby certify that these plans fully depict within reasonable construction tolerances the layout, location, letter identification and dimensions of the buildings and dwellings contained therein.

Wade H. Barber



0235

4328 RV-2