


VOL 1035 PAGE 673

0673

LIMITED COMMON ELEMENTS

FOUNDATION PLAN

CURTAIN WALL

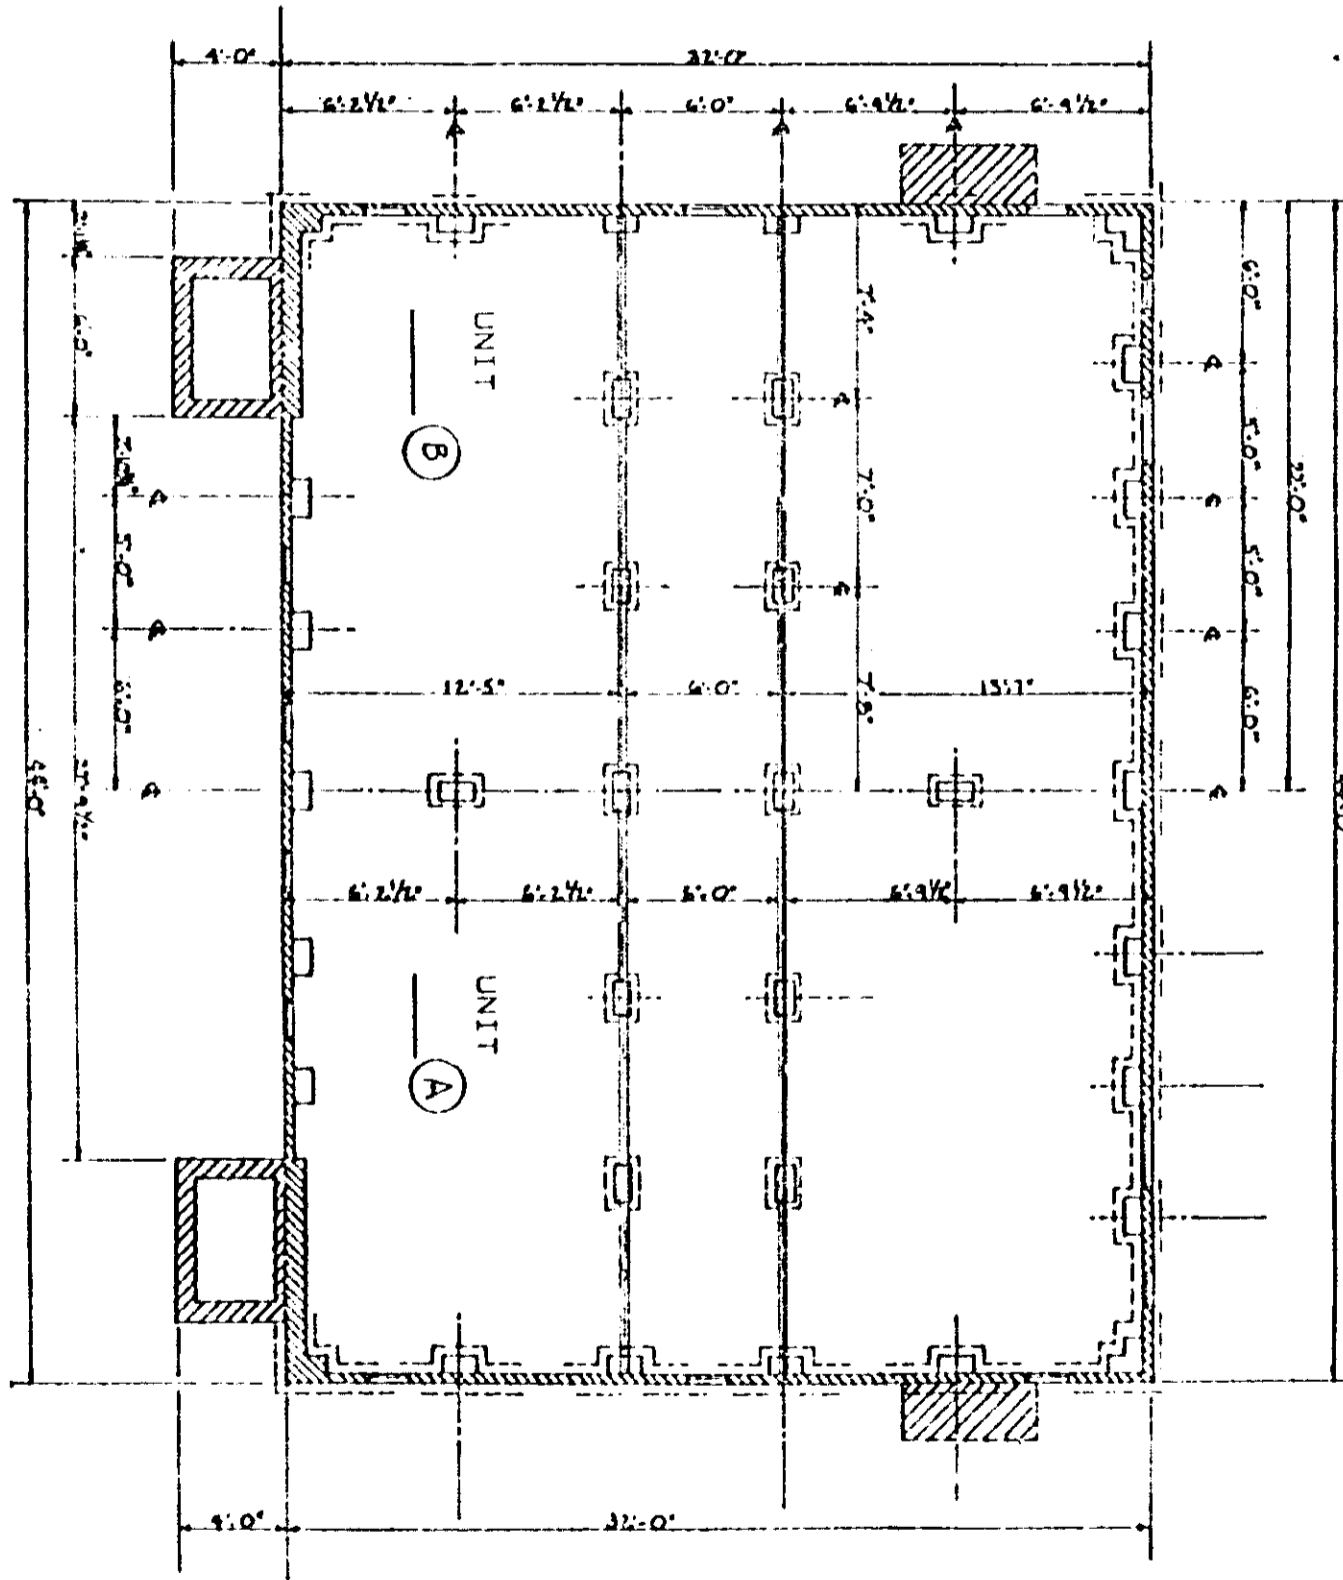

CERTIFICATE

I, Wade H. Barber, do hereby certify that these plans fully depict within reasonable construction tolerances the layout, location, letter identification and dimensions of the buildings and dwellings contained therein.

*Wade H. Barber*



4328 RV-2