

STATE OF SOUTH CAROLINA }
COUNTY OF GREENVILLE }

FILED RIGHT-OF-WAY EASEMENT
CO. S. C.

KNOW ALL MEN BY THESE PRESENTS, that we, the undersigned South Carolina National Bank,
Executor Under Will of Nell Baker Adams for a good and ~~valuable~~ consideration, the receipt whereof is
~~hereby acknowledged~~, do hereby grant unto Laurens Electric Cooperative, Inc., a cooperative corporation, whose
post office address is Laurens, South Carolina, and to its successors and assigns, the right to enter upon the lands of
the undersigned, situated in said County and State:

A tract of land situated on road about 10 miles from
Town of Greenville, and bounded by the lands owned
by Ford Henderson
and McDade

and to construct, operate and maintain on the above-described lands and/or in or upon all streets, roads or high-
ways abutting said lands, an electric or distribution line or system, and to cut and trim trees and shrubbery to the
extent necessary to keep them clear of said electric line or system and to cut down from time to time all dead,
weak, leaning or dangerous trees that are tall enough to strike the wires in falling.

The undersigned covenant that they are the owners of the above-described lands and that the said lands are
free and clear of encumbrances and liens of whatsoever character except those held by the following persons:

IN WITNESS WHEREOF, the undersigned have set their hands and seals this 1st
day of May, 19 79 South Carolina National Bank, Executor
Under Will of Nell Baker Adams

Witness:
Medred C. Mcbee
John R. Jones

BY: Ellison G. Webster III (L. S.)
Ellison G. Webster III, V.P. & T.O.
John R. Jones (L. S.)
John R. Jones, A.T.O.

STATE OF SOUTH CAROLINA }
COUNTY OF GREENVILLE }


PROBATE BY SUBSCRIBING WITNESS

PERSONALLY appeared before me one of the above witnesses and made oath that he was present and saw the
within named grantor sign, seal and as his act and deed deliver the within written deed, for the uses and purposes
therein mentioned, and that he, with the second witness shown witnessed the execution thereof.

SWORN to before me this 1st day
of May, 19 79
Medred C. Mcbee
Notary Public for S. C.
My Commission Expires 1-1-80

Medred C. Mcbee
(One witness sign)

SKETCH OF PROPOSED LINES:

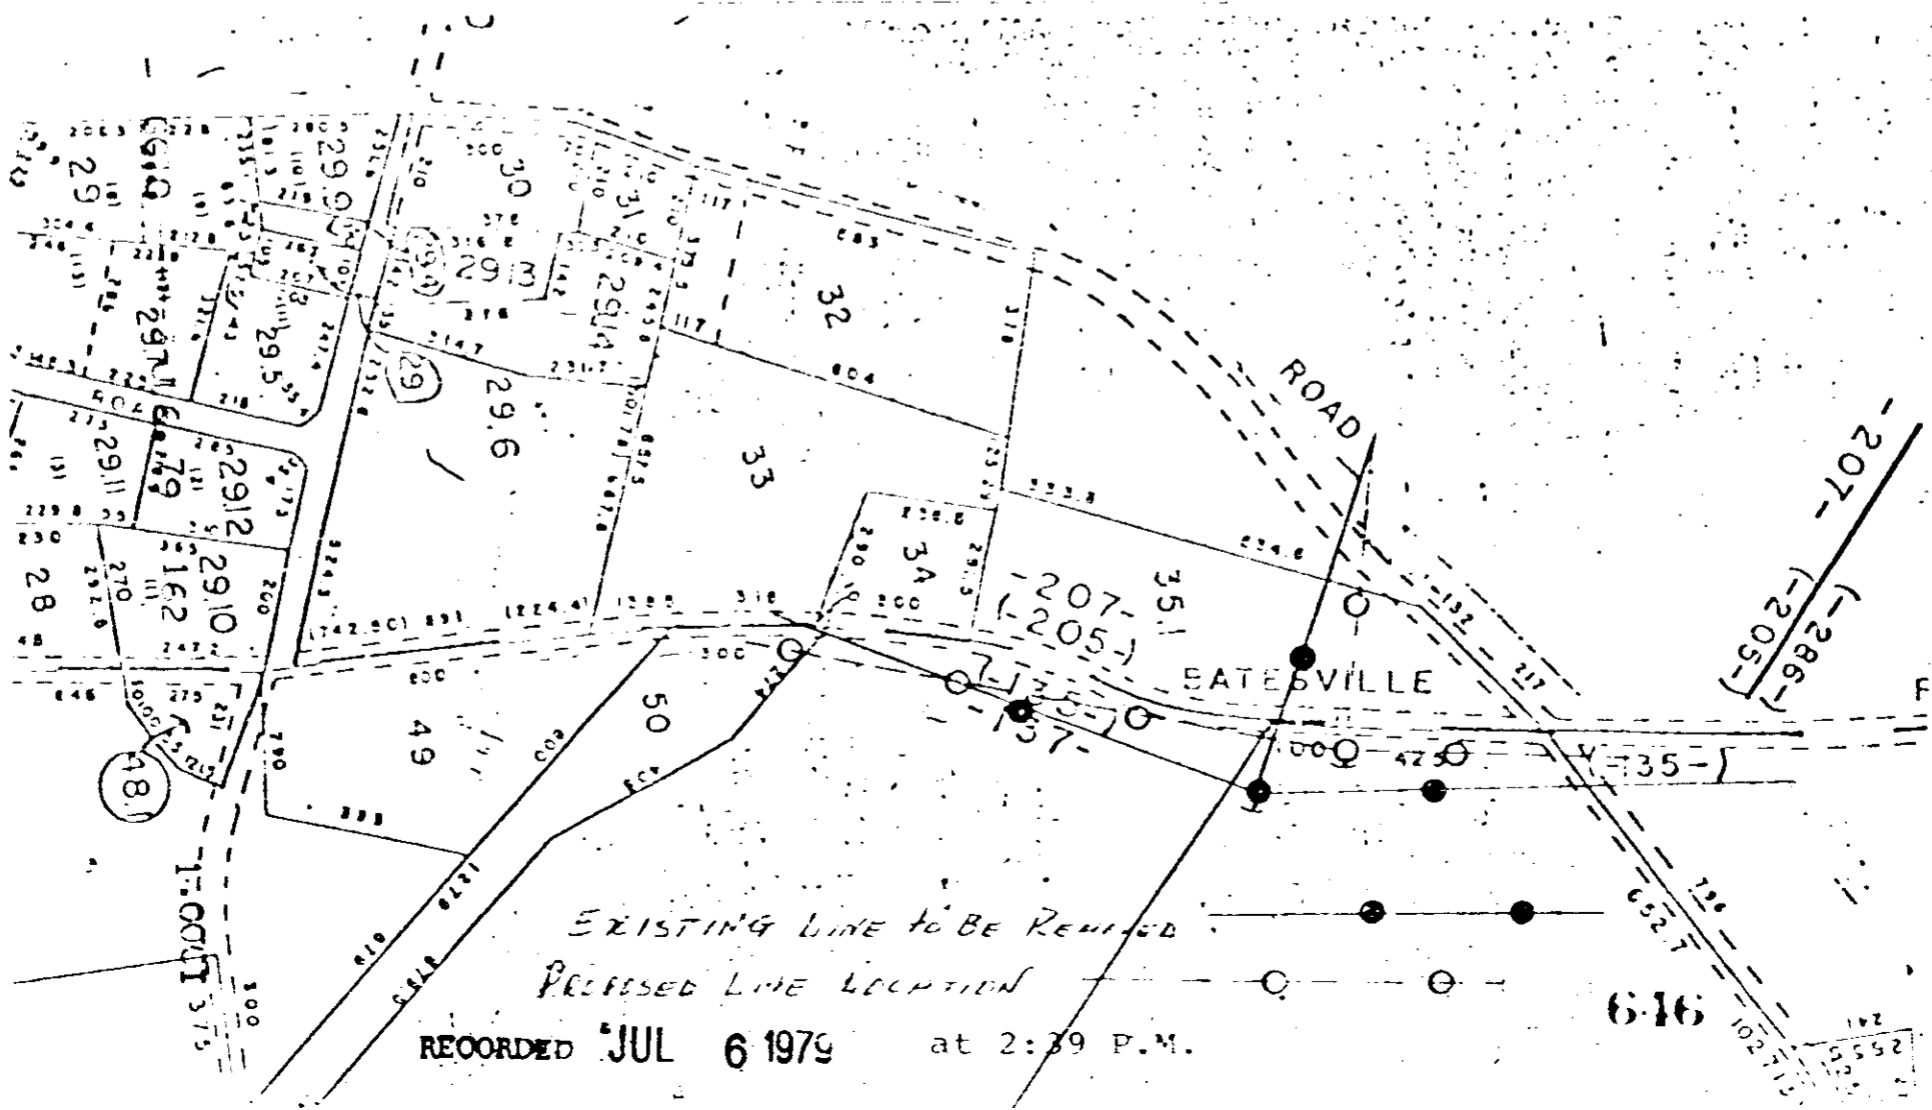

4328 RV-2

0329