


Name and Post Office Address of Grantor: Batson, Bobby E.
22 Stono Dr.
Greenville, S. C. 29609

Toll Line or Exchange Line tributary to: Greenville, S. C.

The Property is bounded where the line enters and leaves this property by the property of
Parker Road on the South
and Foister, Jethro & Grace on the East
Authority: P-43369 Classification: R45C
Area: Greenville, S. C.
Approved: J. J. Kyle
Title: Dist. High Dist

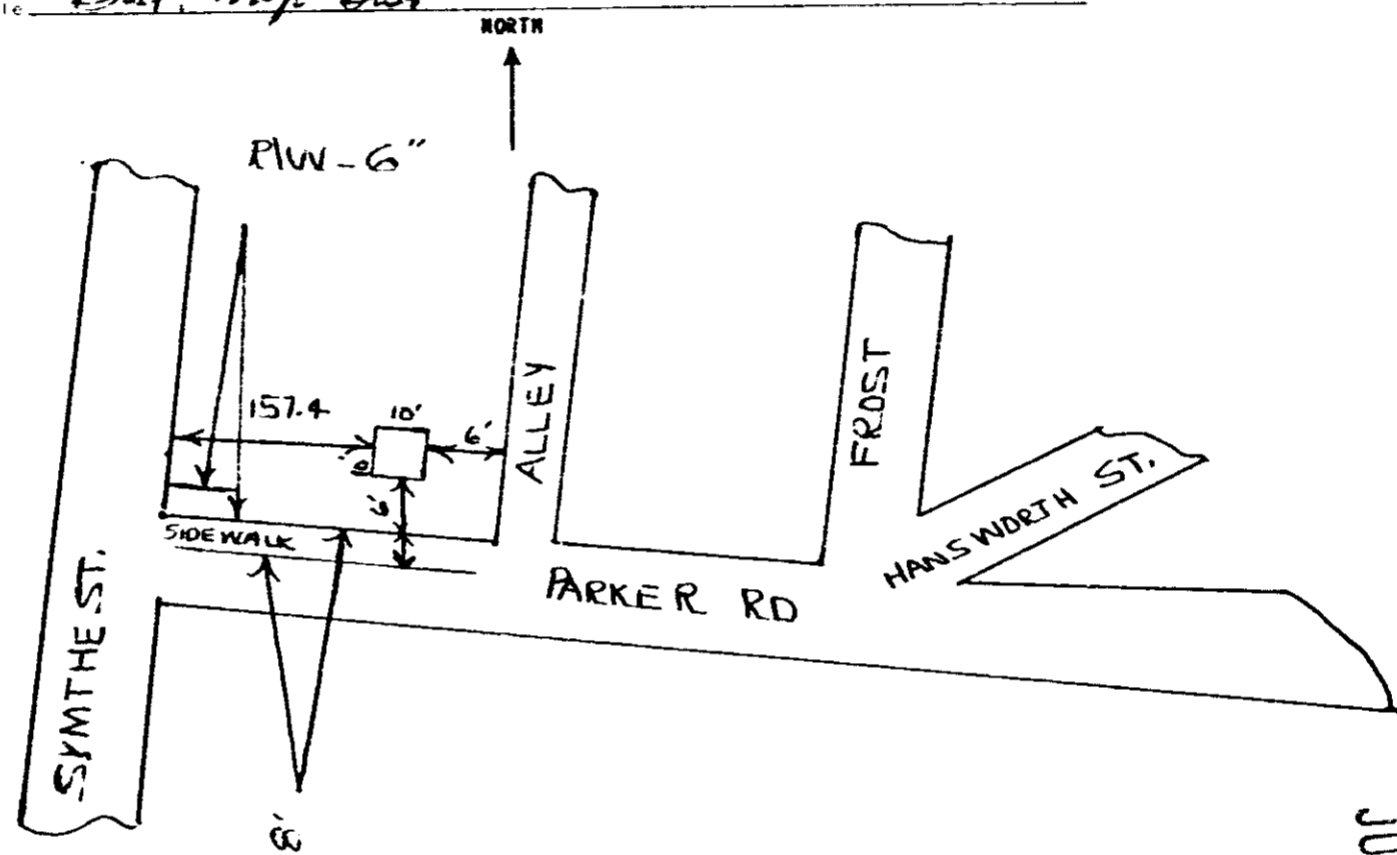

RECORDED JUL 10 1979 9:15

JUL 10 1979

9:15 K V

to M. C. for G. Co. & C.
at page 19
of in Deed Book

4328 RV-2

0 4 9 7 0