VOL 1108 PAGE 847

EXHIBIT C

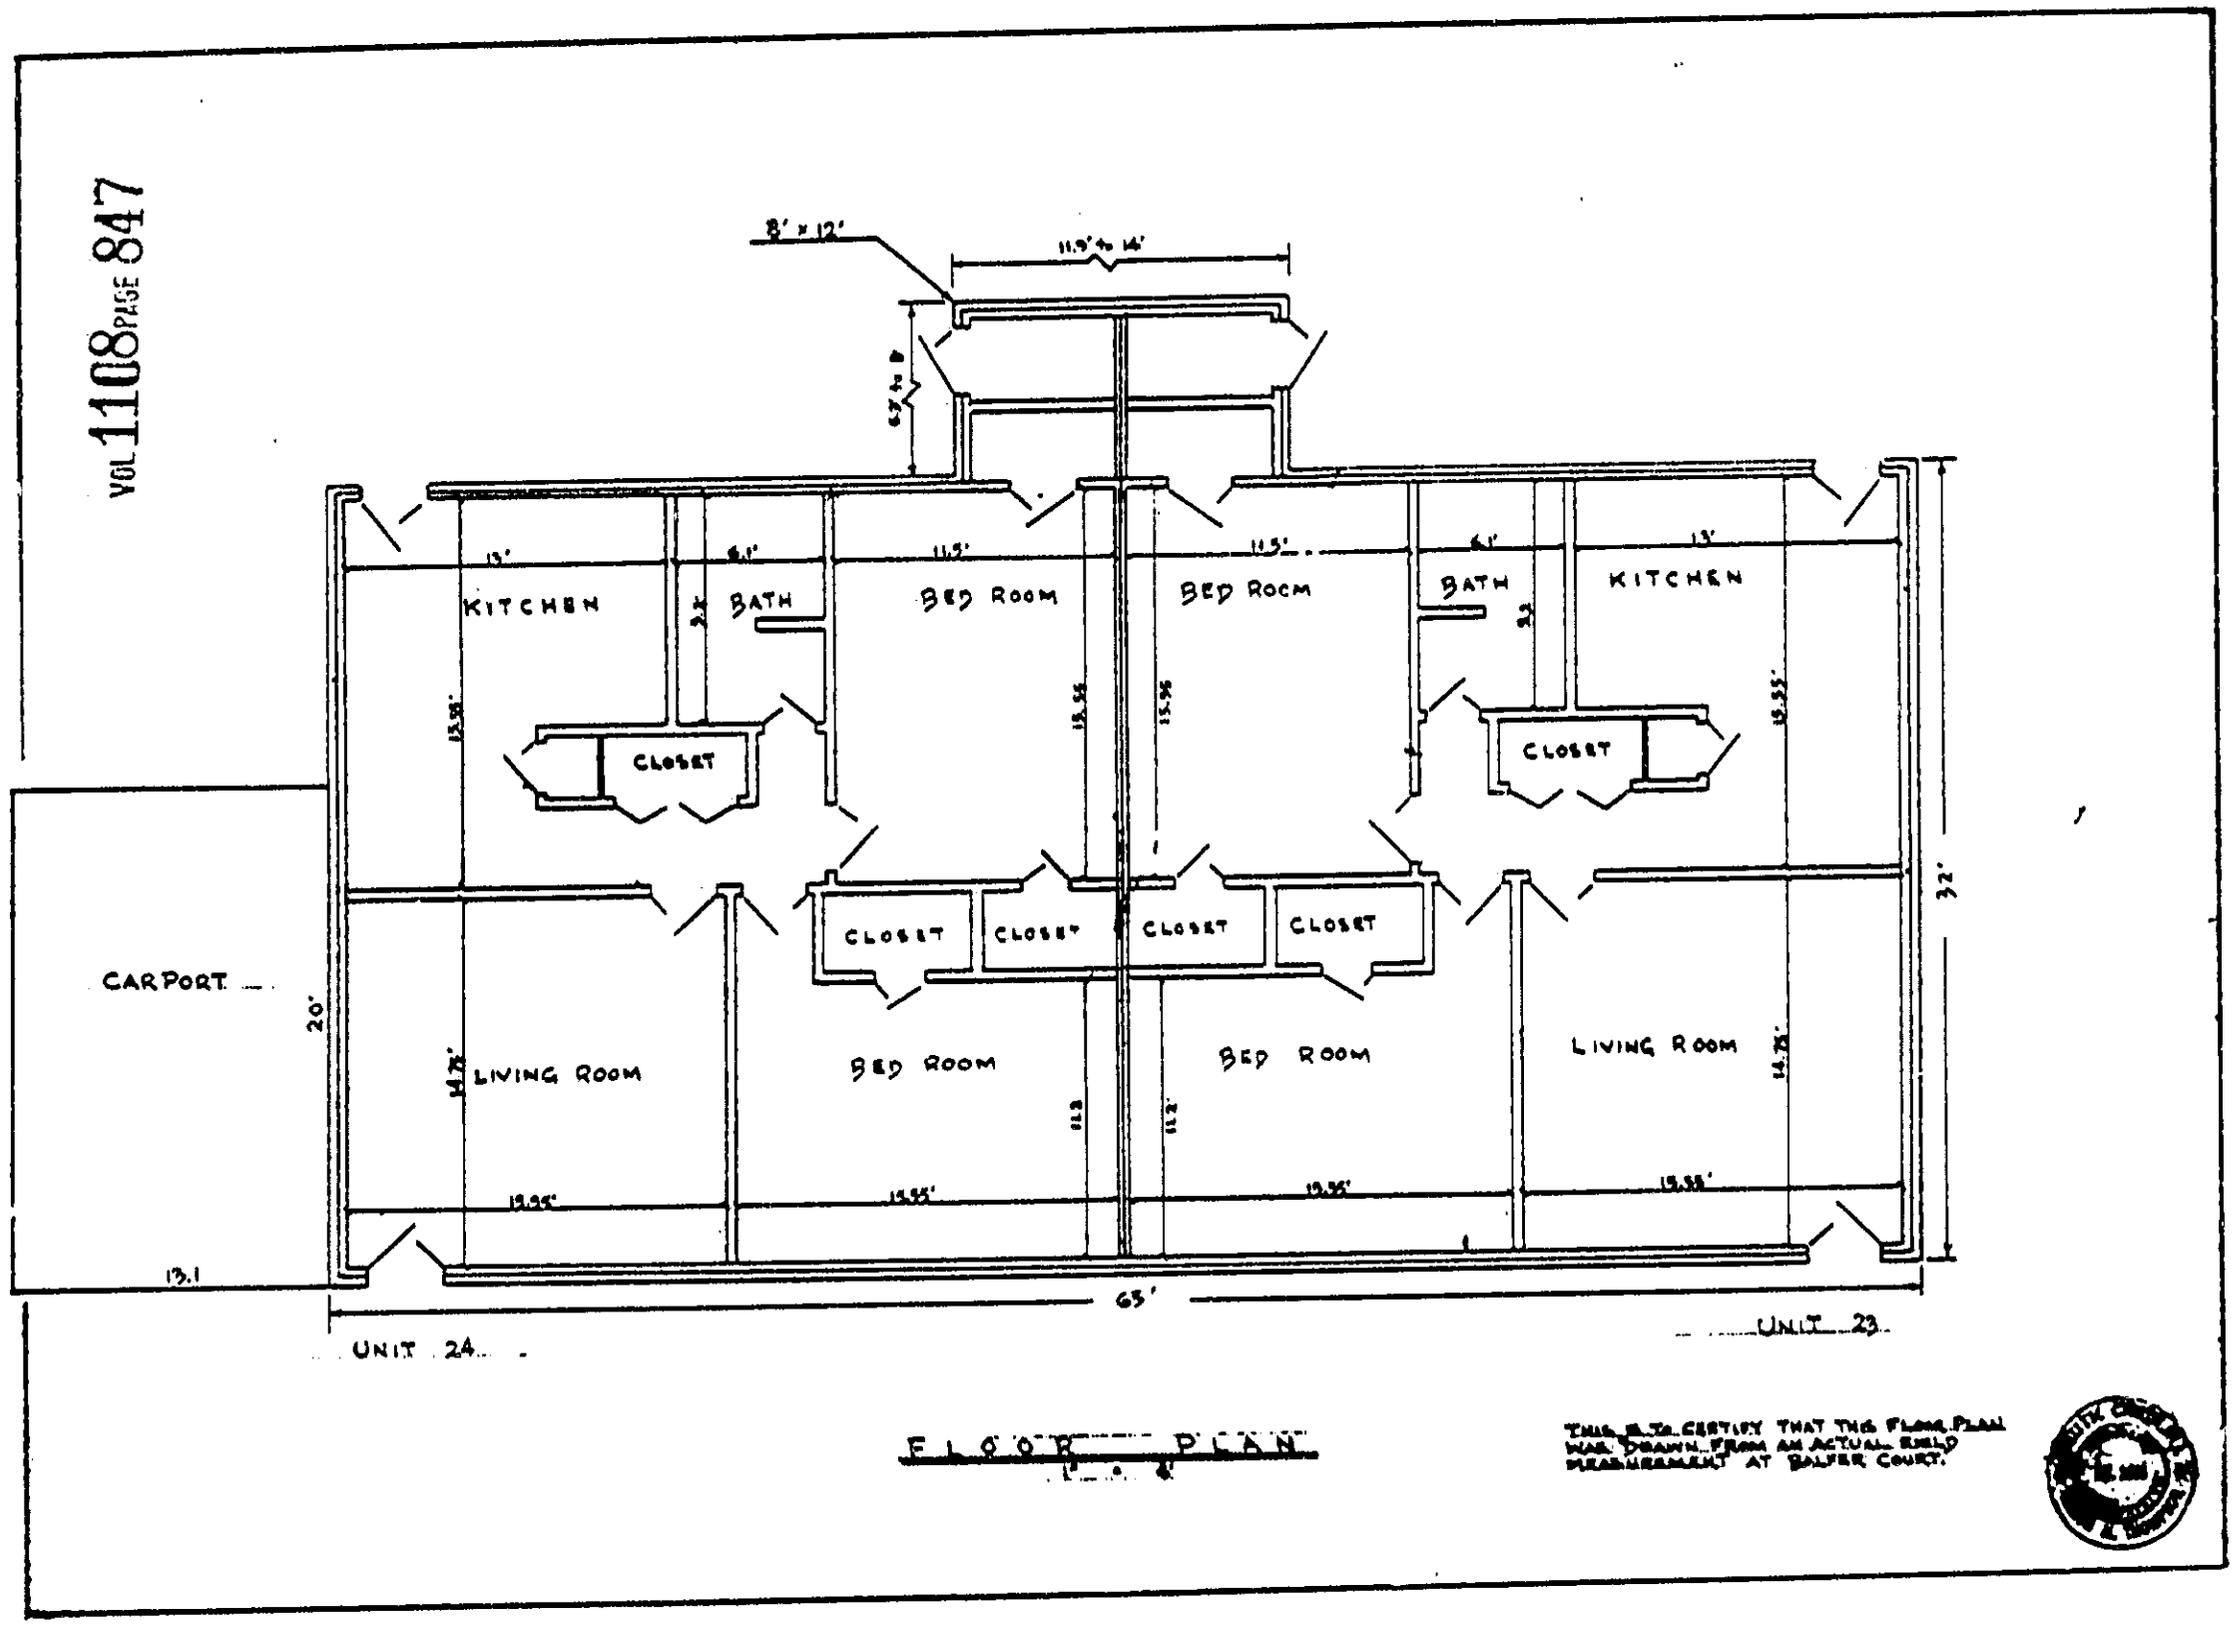

FLOOR PLAN

THIS IS TO CERTIFY THAT THIS FLOOR PLAN WAS DRAWN FROM AN ACTUAL FIELD MEASUREMENT AT BALFER COURT.