

I JAMES R. FREELAND  
HEREBY CERTIFY  
THAT THE WITHIN  
FLOOR PLANS ARE  
TRUE AND CORRECT  
SEDFIELD VILLAS  
HORIZONTAL PROPERTY  
REGIME  
UNIT 2

*James R. Freeland*

AREA PER RESIDENCE  
(SQUARE FEET)  
1ST LEVEL 553.44  
2ND LEVEL 630.94  
TOTAL 1184.38

FREELAND & ASSOCIATES  
Engineers Land Surveyors


GREENVILLE, S.C.

DATE FEB. 22. 80


SCALE 1/8" = 1'

SHEET //

DWG. NO. 4755-6

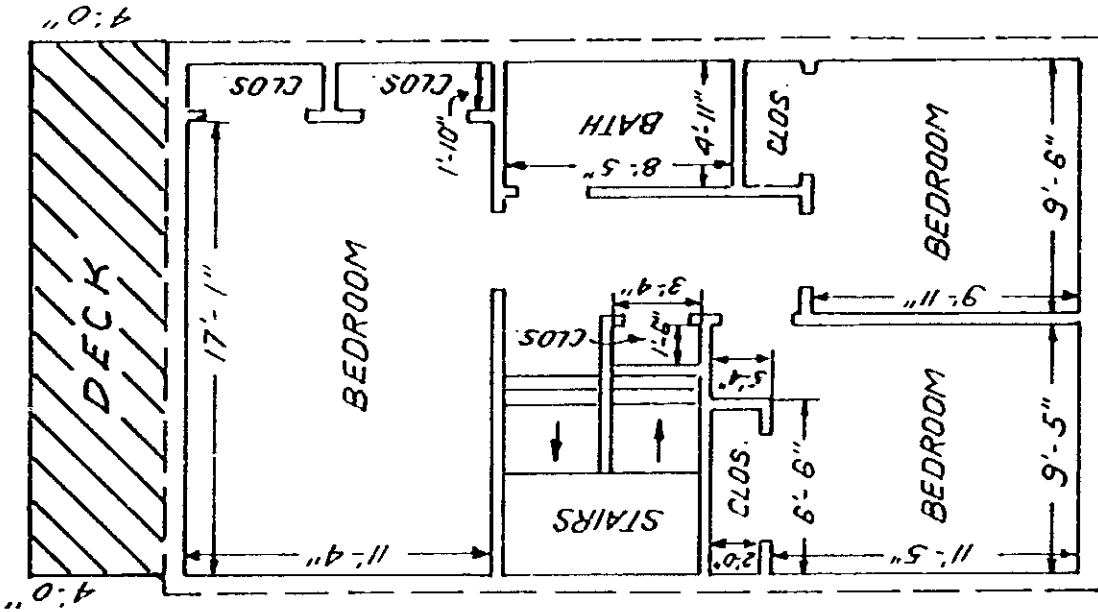

2<sup>ND</sup> LEVEL

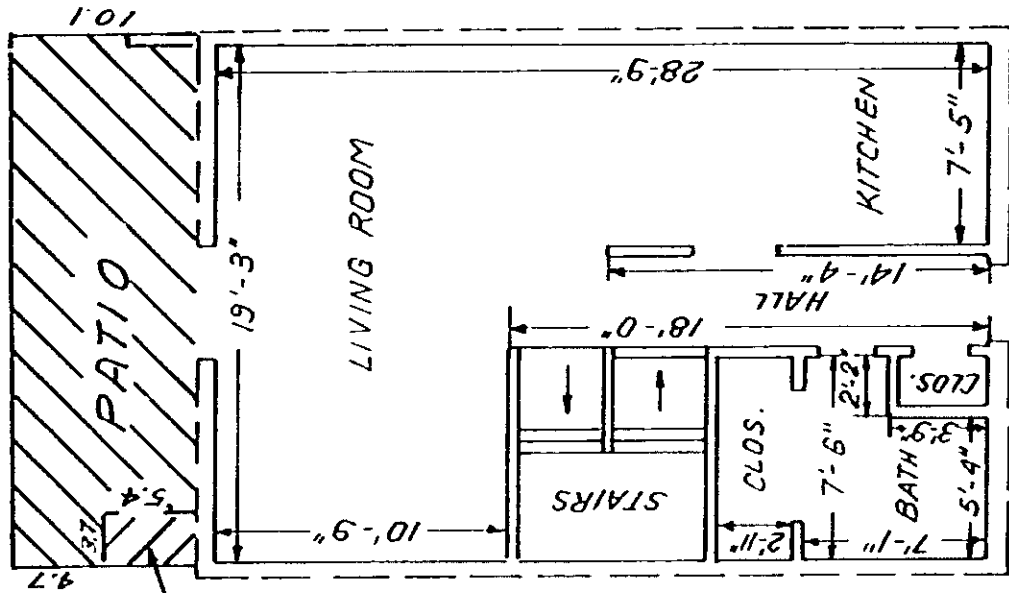

1<sup>ST</sup> LEVEL

FLOOR PLAN FOR THREE BEDROOM  
SEDFIELD VILLAS  
HORIZONTAL PROPERTY REGIME

LEGEND

— UNIT BOUNDARY

--- COMMON ELEMENTS

▨ LIMITED COMMON ELEMENTS