


11410-155

EXHIBIT B, PAGE 1

1870

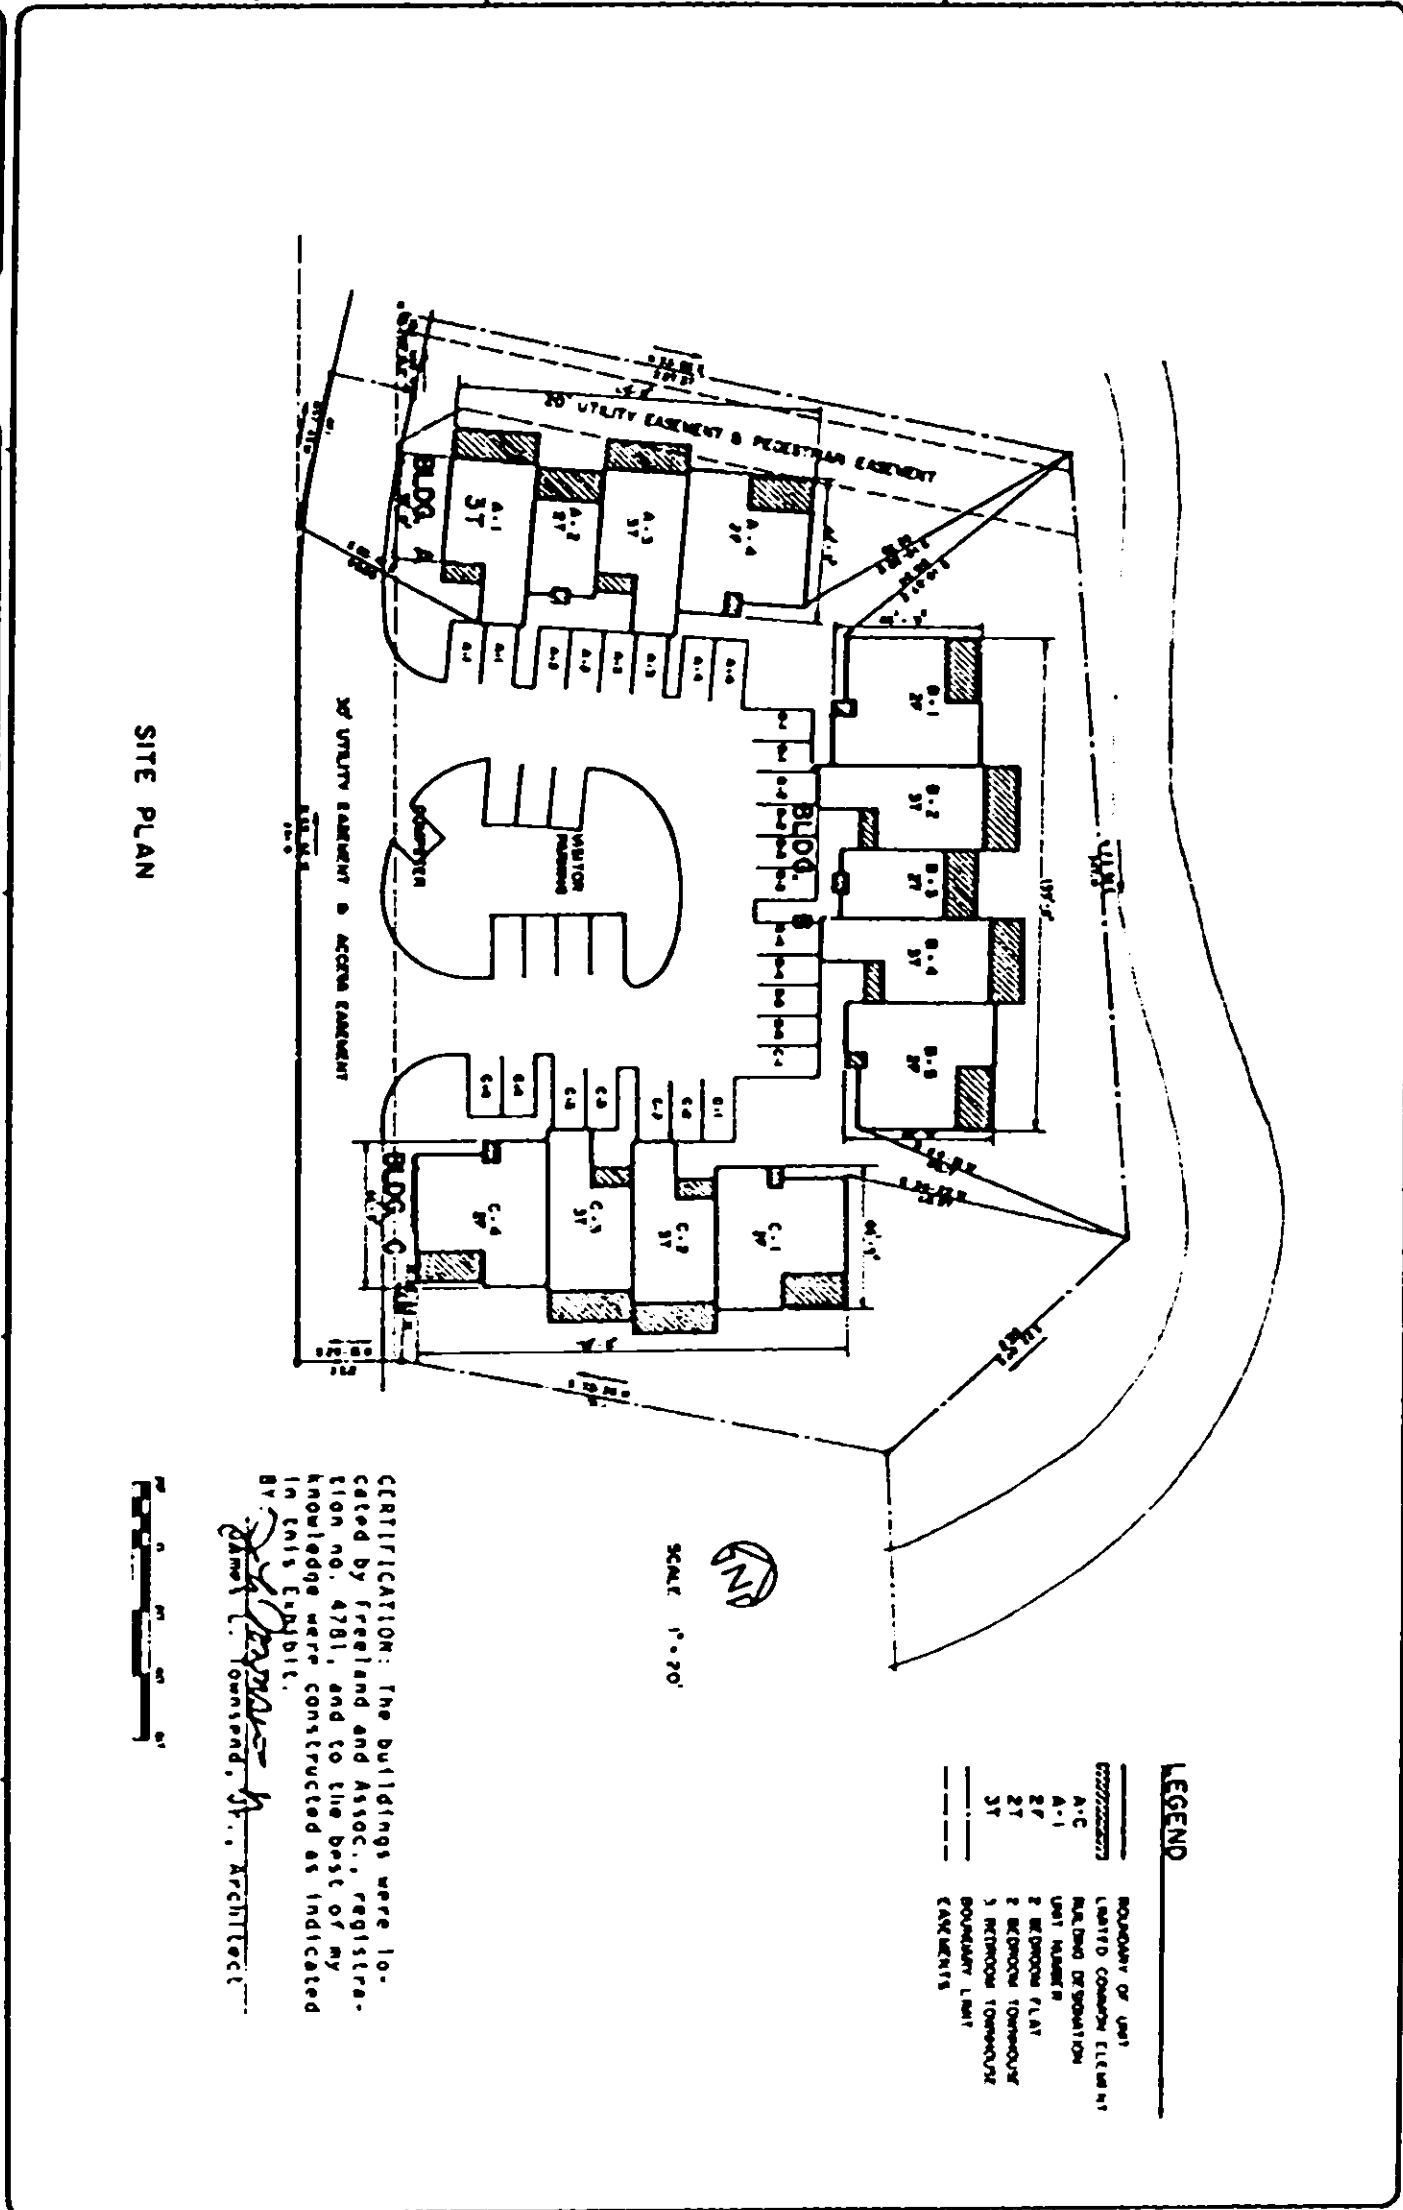

SITE PLAN

REVISED: 1-22-80

MCDANIEL GREENE TOWN HOMES
GREENVILLE, S.C.

MCDANIEL GREENE NORTH
SITE PLAN

MBTB ARCHITECTS
ENGINEERS
P.O. BOX 1598 GREENVILLE, S.C. 29617-0598

CERTIFICATION: The buildings were located by Freeland and Assoc., registration no. 4781, and to the best of my knowledge were constructed as indicated in this exhibit.
BY: *[Signature]*



SCALE 1"=20'

LEGEND

--- (dashed line)	BOUNDARY OF UNIT

11

4328 RV-2

RECORD: MAR 11 1981 at 12:35 P.M.

25417