


Name and Post Office Address of Grantor JAMES B. TANKERSLEY  
RIVER FALLS ROAD  
CLEVELAND, SOUTH CAROLINA

Toll Line or Exchange Line tributary to \_\_\_\_\_ (Name)  
\_\_\_\_\_ (Exchange)

The Property is bounded where the line enters and leaves this property by the property of:  
MIDDLE SALUDA RIVER on the SOUTH  
and ROAD S-23-97 on the EAST  
Authority C-6679 Classification R45C

Area \_\_\_\_\_  
Approved \_\_\_\_\_  
Title \_\_\_\_\_

33113 X  
MAY 29 1981

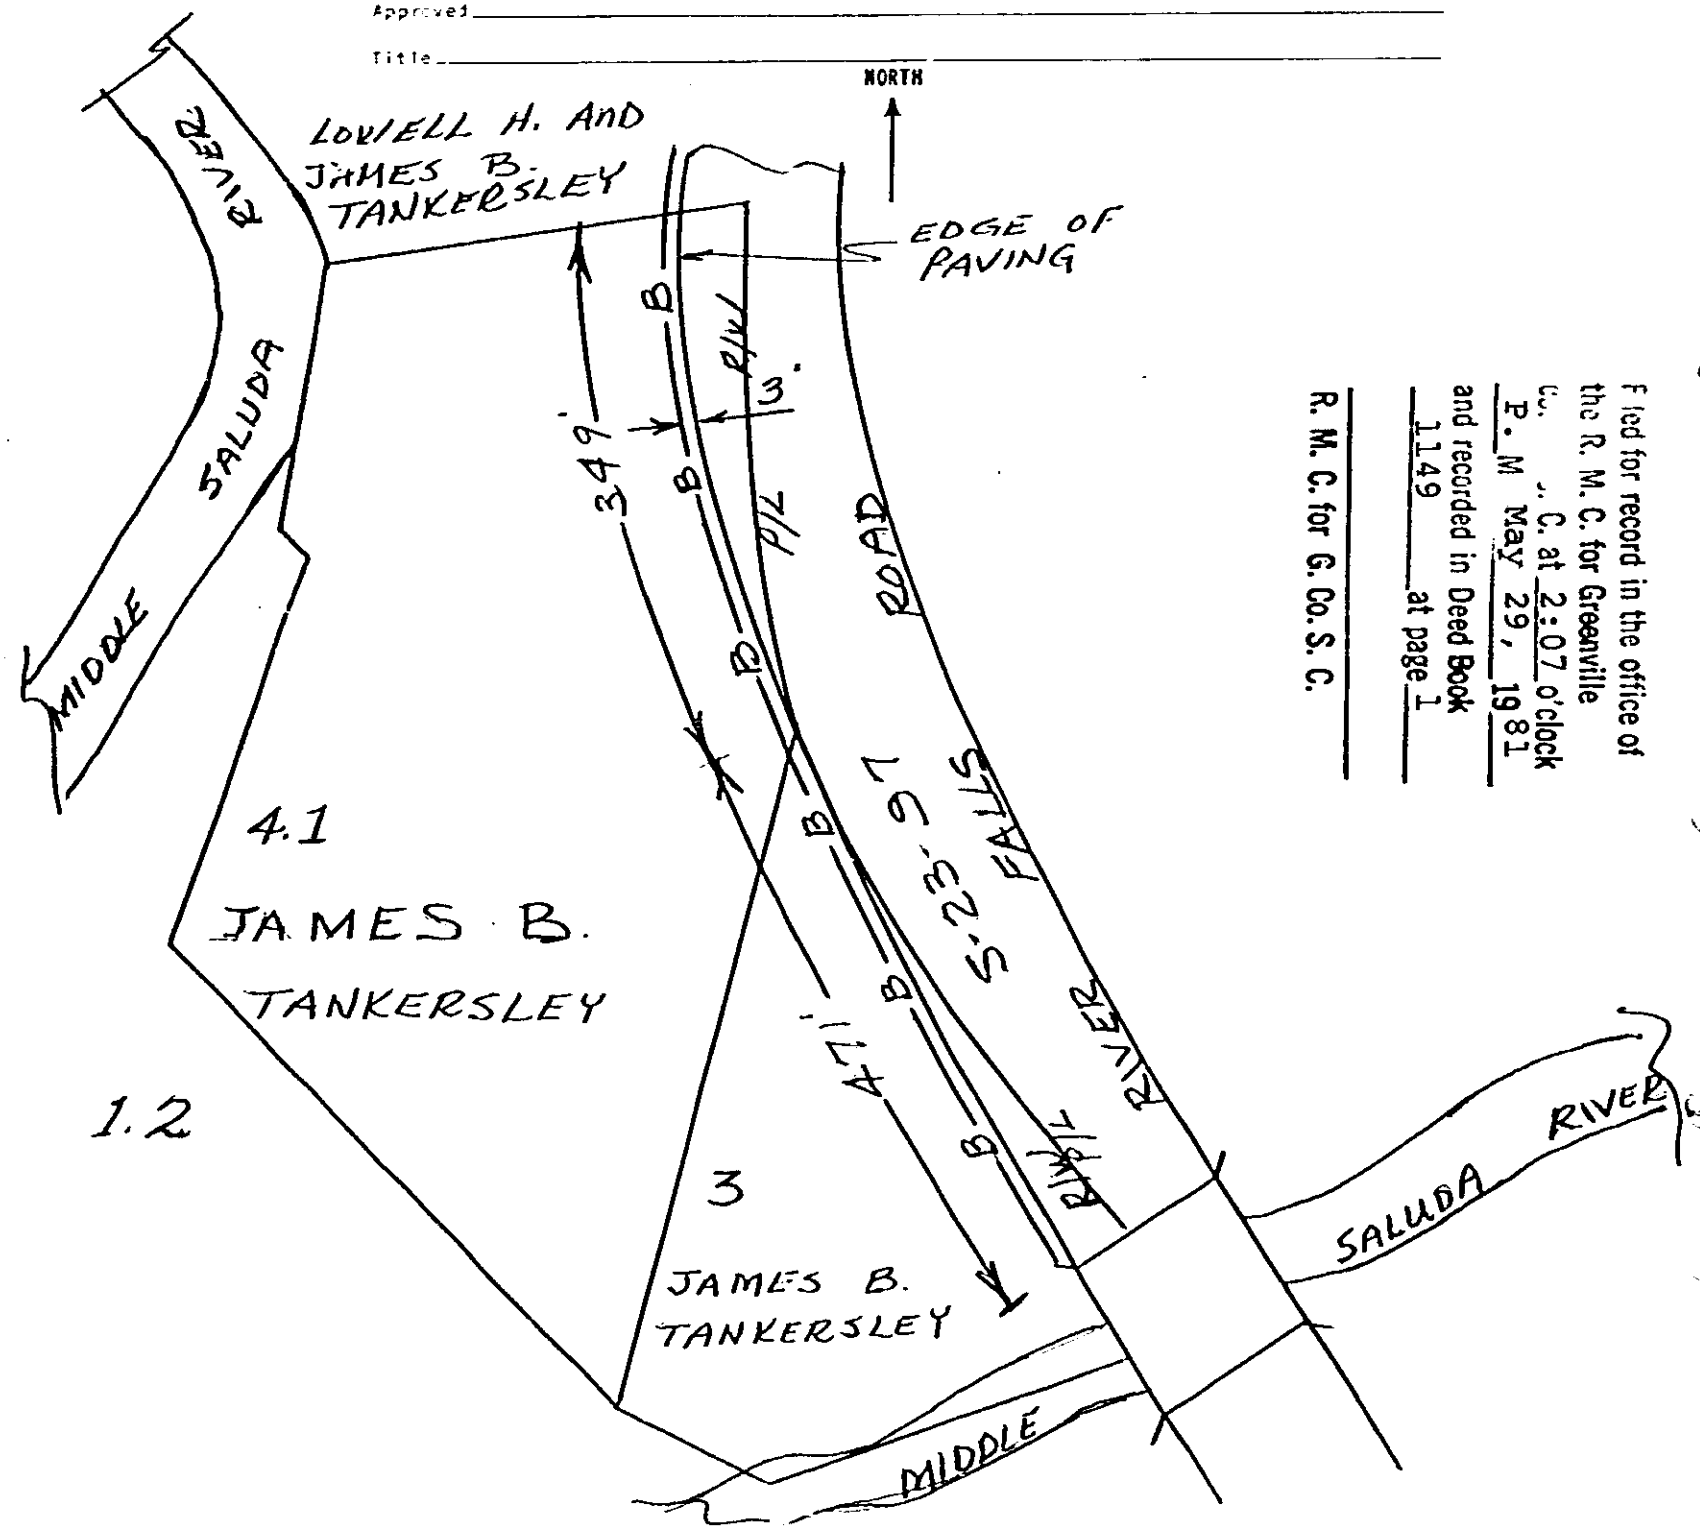

Fled for record in the office of  
the R. M. C. for Greenville  
Co., S. C. at 2:07 o'clock  
P. M. May 29, 1981  
and recorded in Deed Book  
1149 at page 1  
R. M. C. for G. Co. S. C.

RECORDED MAY 29 1981 at 2:07 P.M.

33113

4328 RV-2