


BOOK 1149 PAGE 804

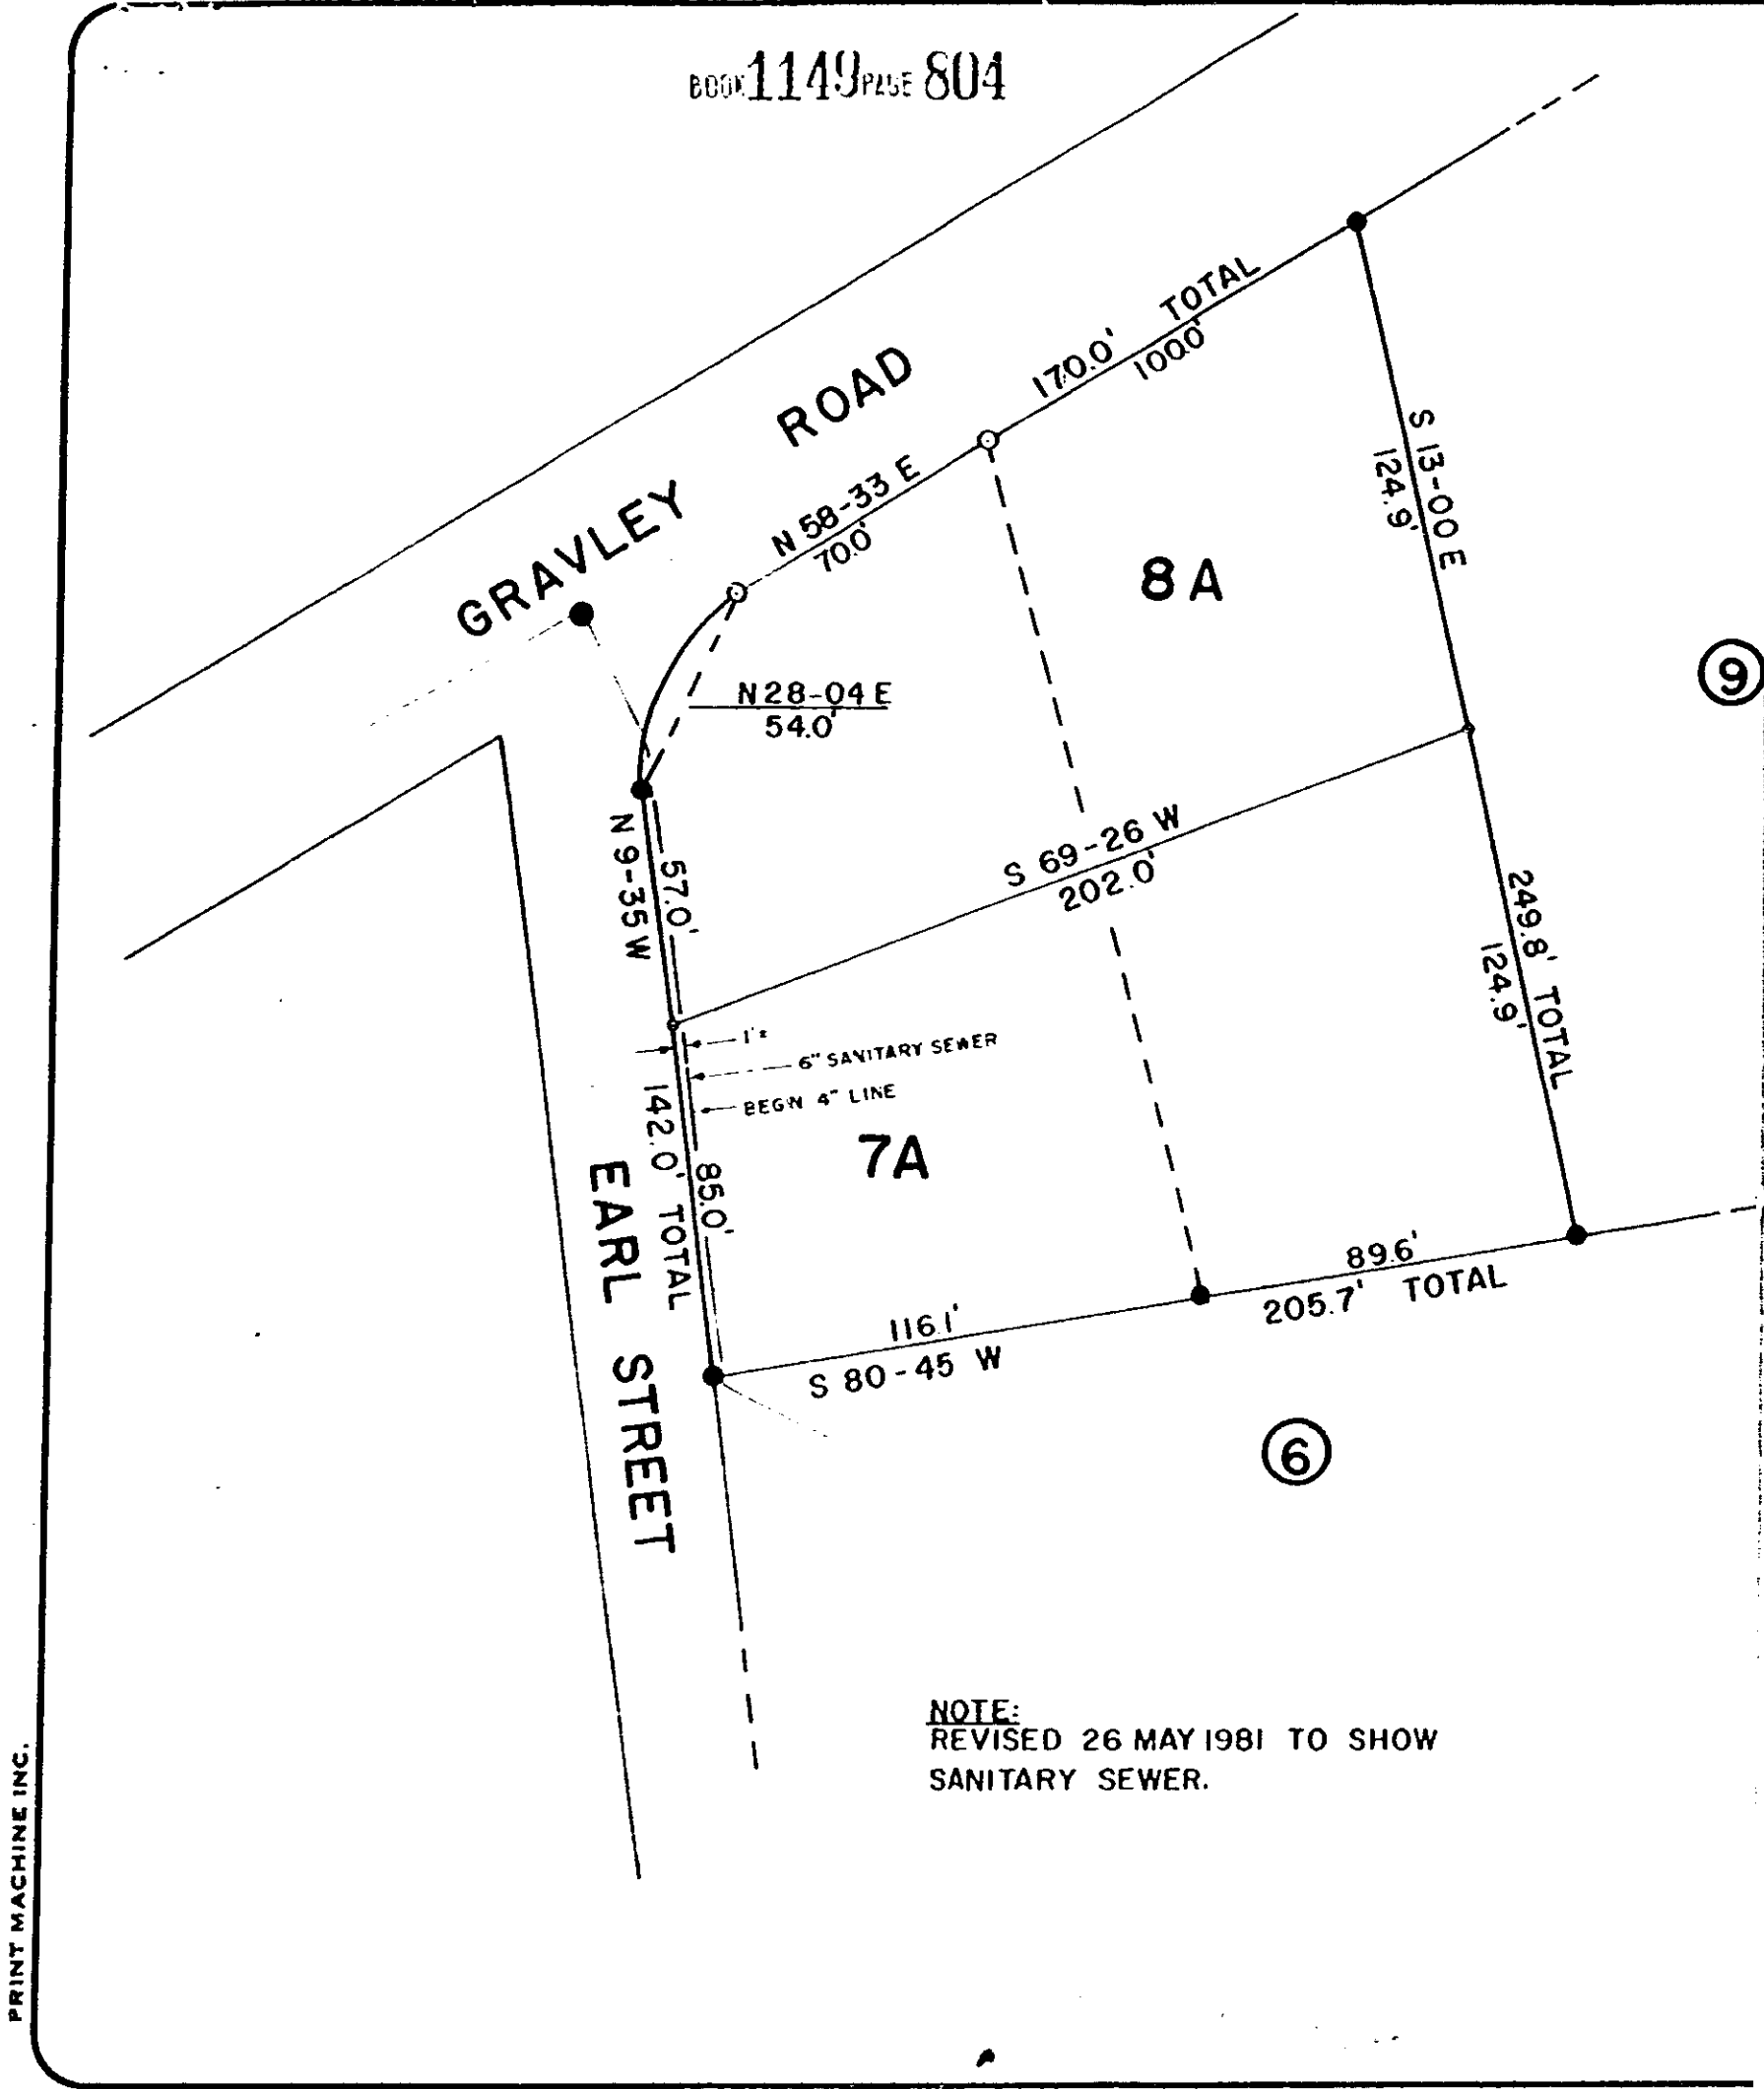

PRINT MACHINE INC.

0.80.4

4328 RV-2