


520

BOOK 1154 PAGE 753

Material List:

8" D. I. Pipe	820'±
6" D. I. Pipe	16'±
8" Valve	1
6" Valve	1
2" Valve	1
Fire Hydrant	1

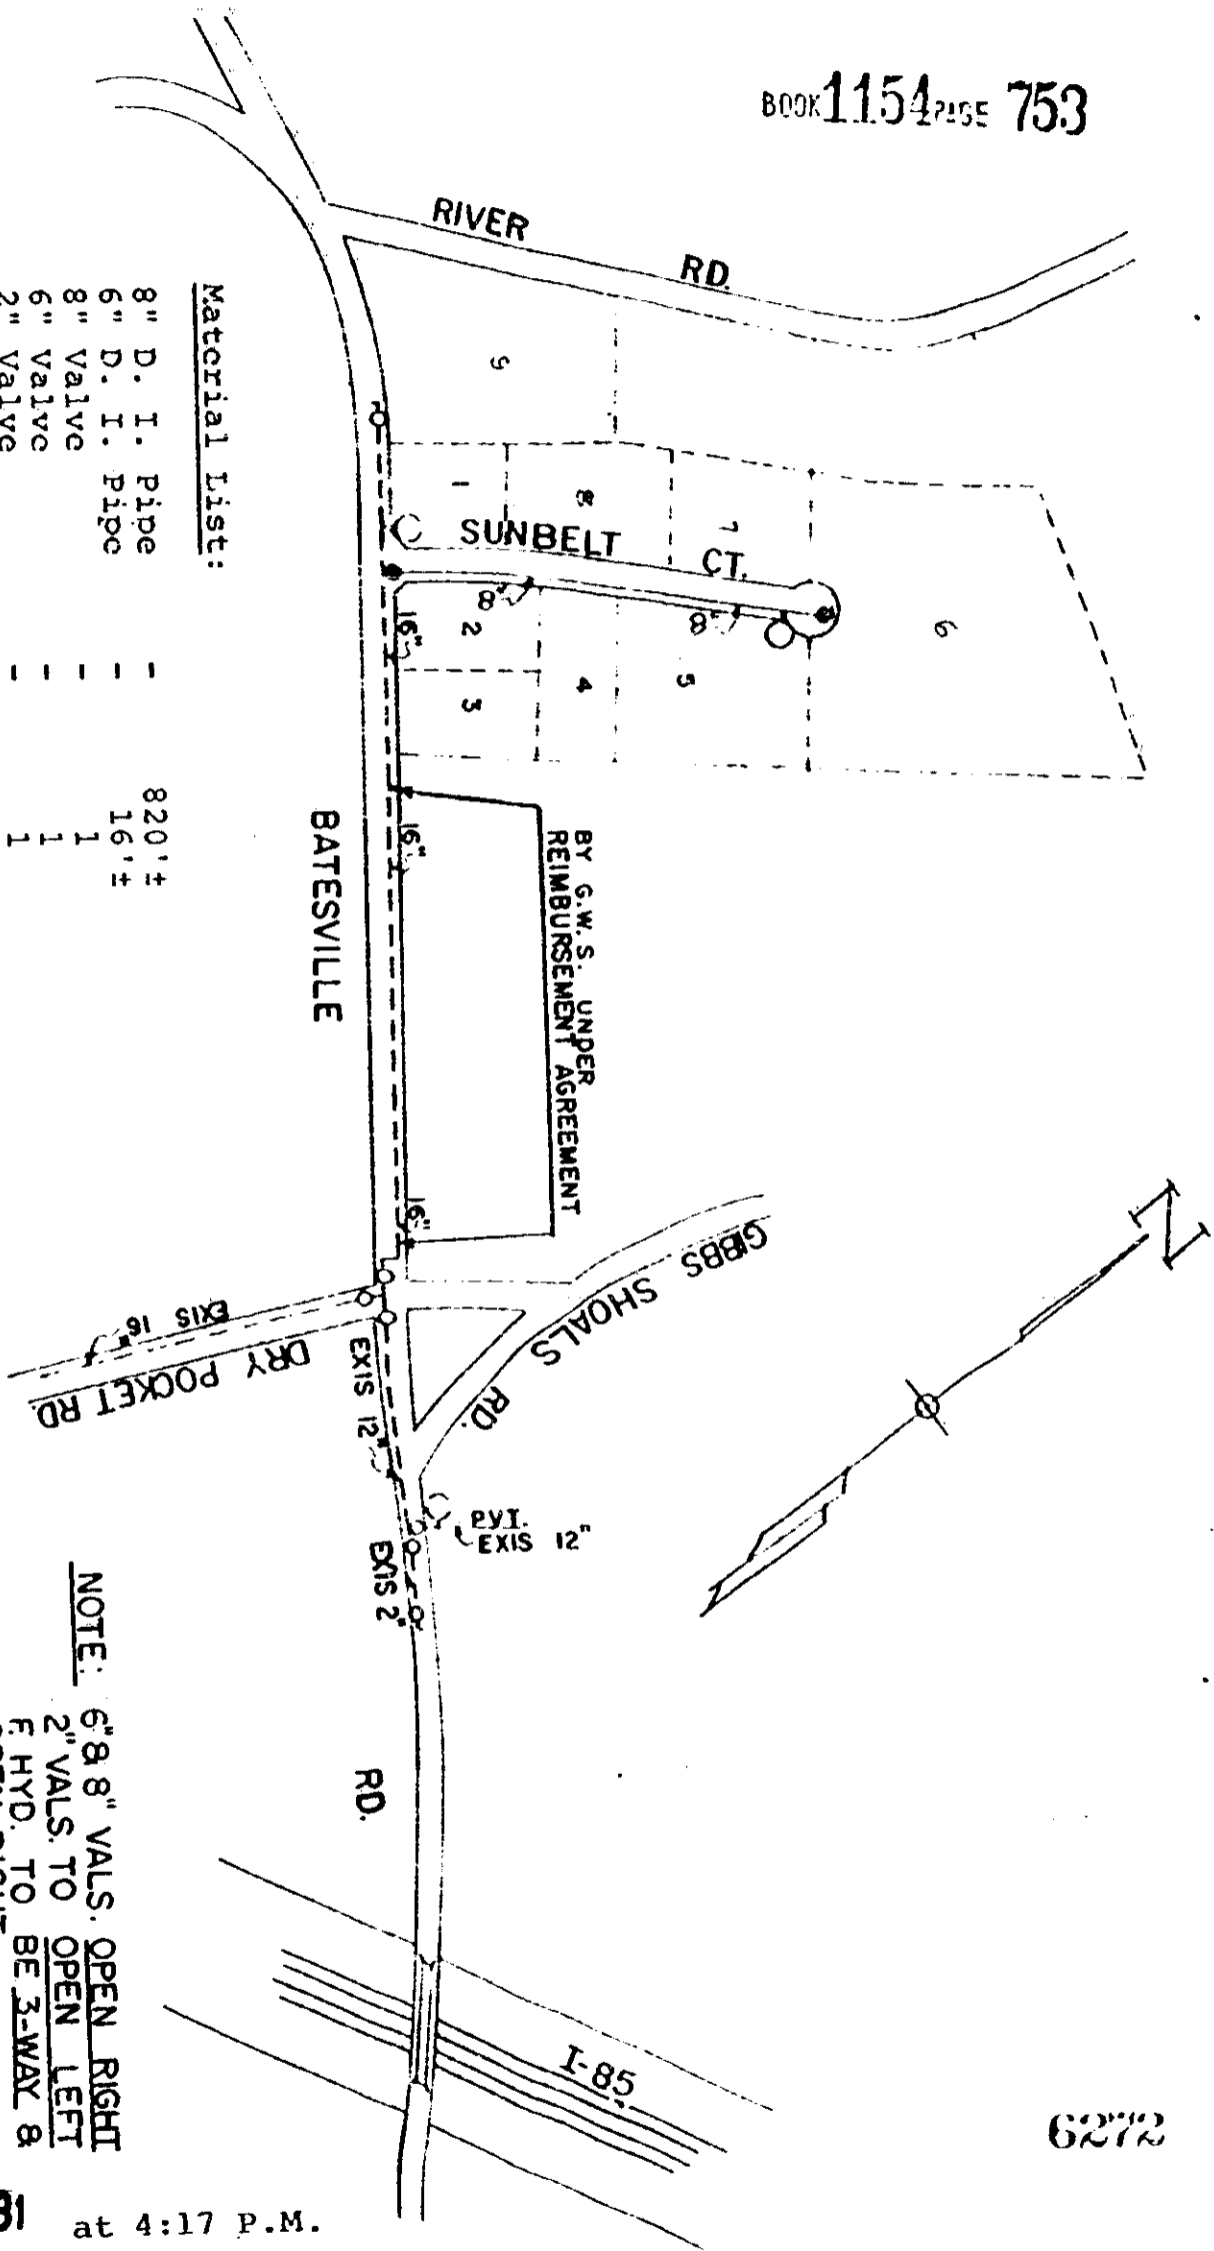

NOTE: 6" & 8" VALS. OPEN RIGHT
 2" VALS. TO OPEN LEFT
 F. HYD. TO BE 3-WAY &
 OPEN RIGHT

SUNBELT PARK
 JUNE 1981 SCALE 1" = 400'
 Donald F. Waggoner
 to
 Commissioners of Public Works
 of the City of Greenville, S. C.
 August 26, 1981
 Pt. of BLK. BOOK 534.1-1-4

RECORDED SEP 8 1981 at 4:17 P.M.

6272

4328 RV-2