

BOOK 1155 PAGE 31


Name and Post Office address of Grantor: Judson Mills ~~_____~~ Div., Milliken & Company
Box 1448
Greenville, SC 29611

Toll Line or Exchange Line tributary to: Greenville, South Carolina
(Area) (Exchange)

The Property is bounded where the line enters and leaves this property by the property of:
Easley Bridge Road on the North
 and Kirk Street on the East

Authority: P-43323 Classification: R45C
 Area: South Carolina

Approved: _____
 Title: District Manager - Distribution

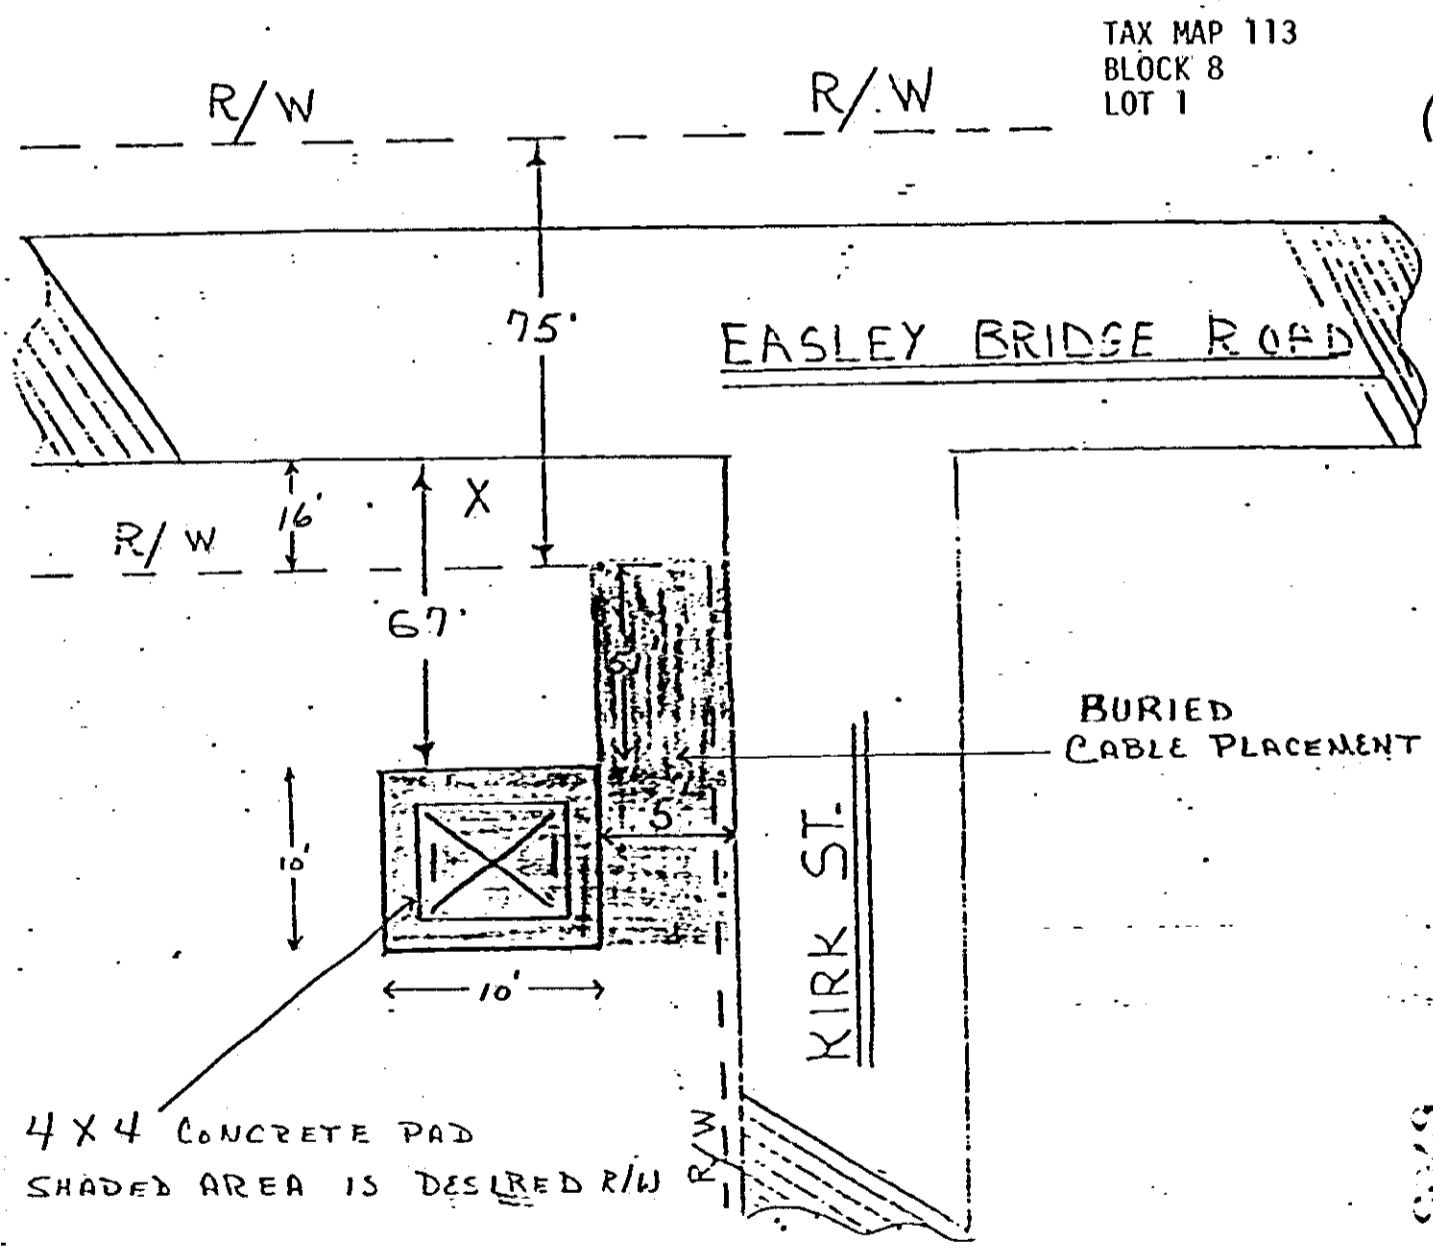

TAX MAP 113
BLOCK 8
LOT 1

4 X 4 CONCRETE PAD
SHADED AREA IS DESIRED R/W

RECORDED SEP 14 1981 at 10:54 A.M.

5705

SEP 14 1981
5:25 PM

4328 RV-2