


timmons drive

end of exist. asphalt drive

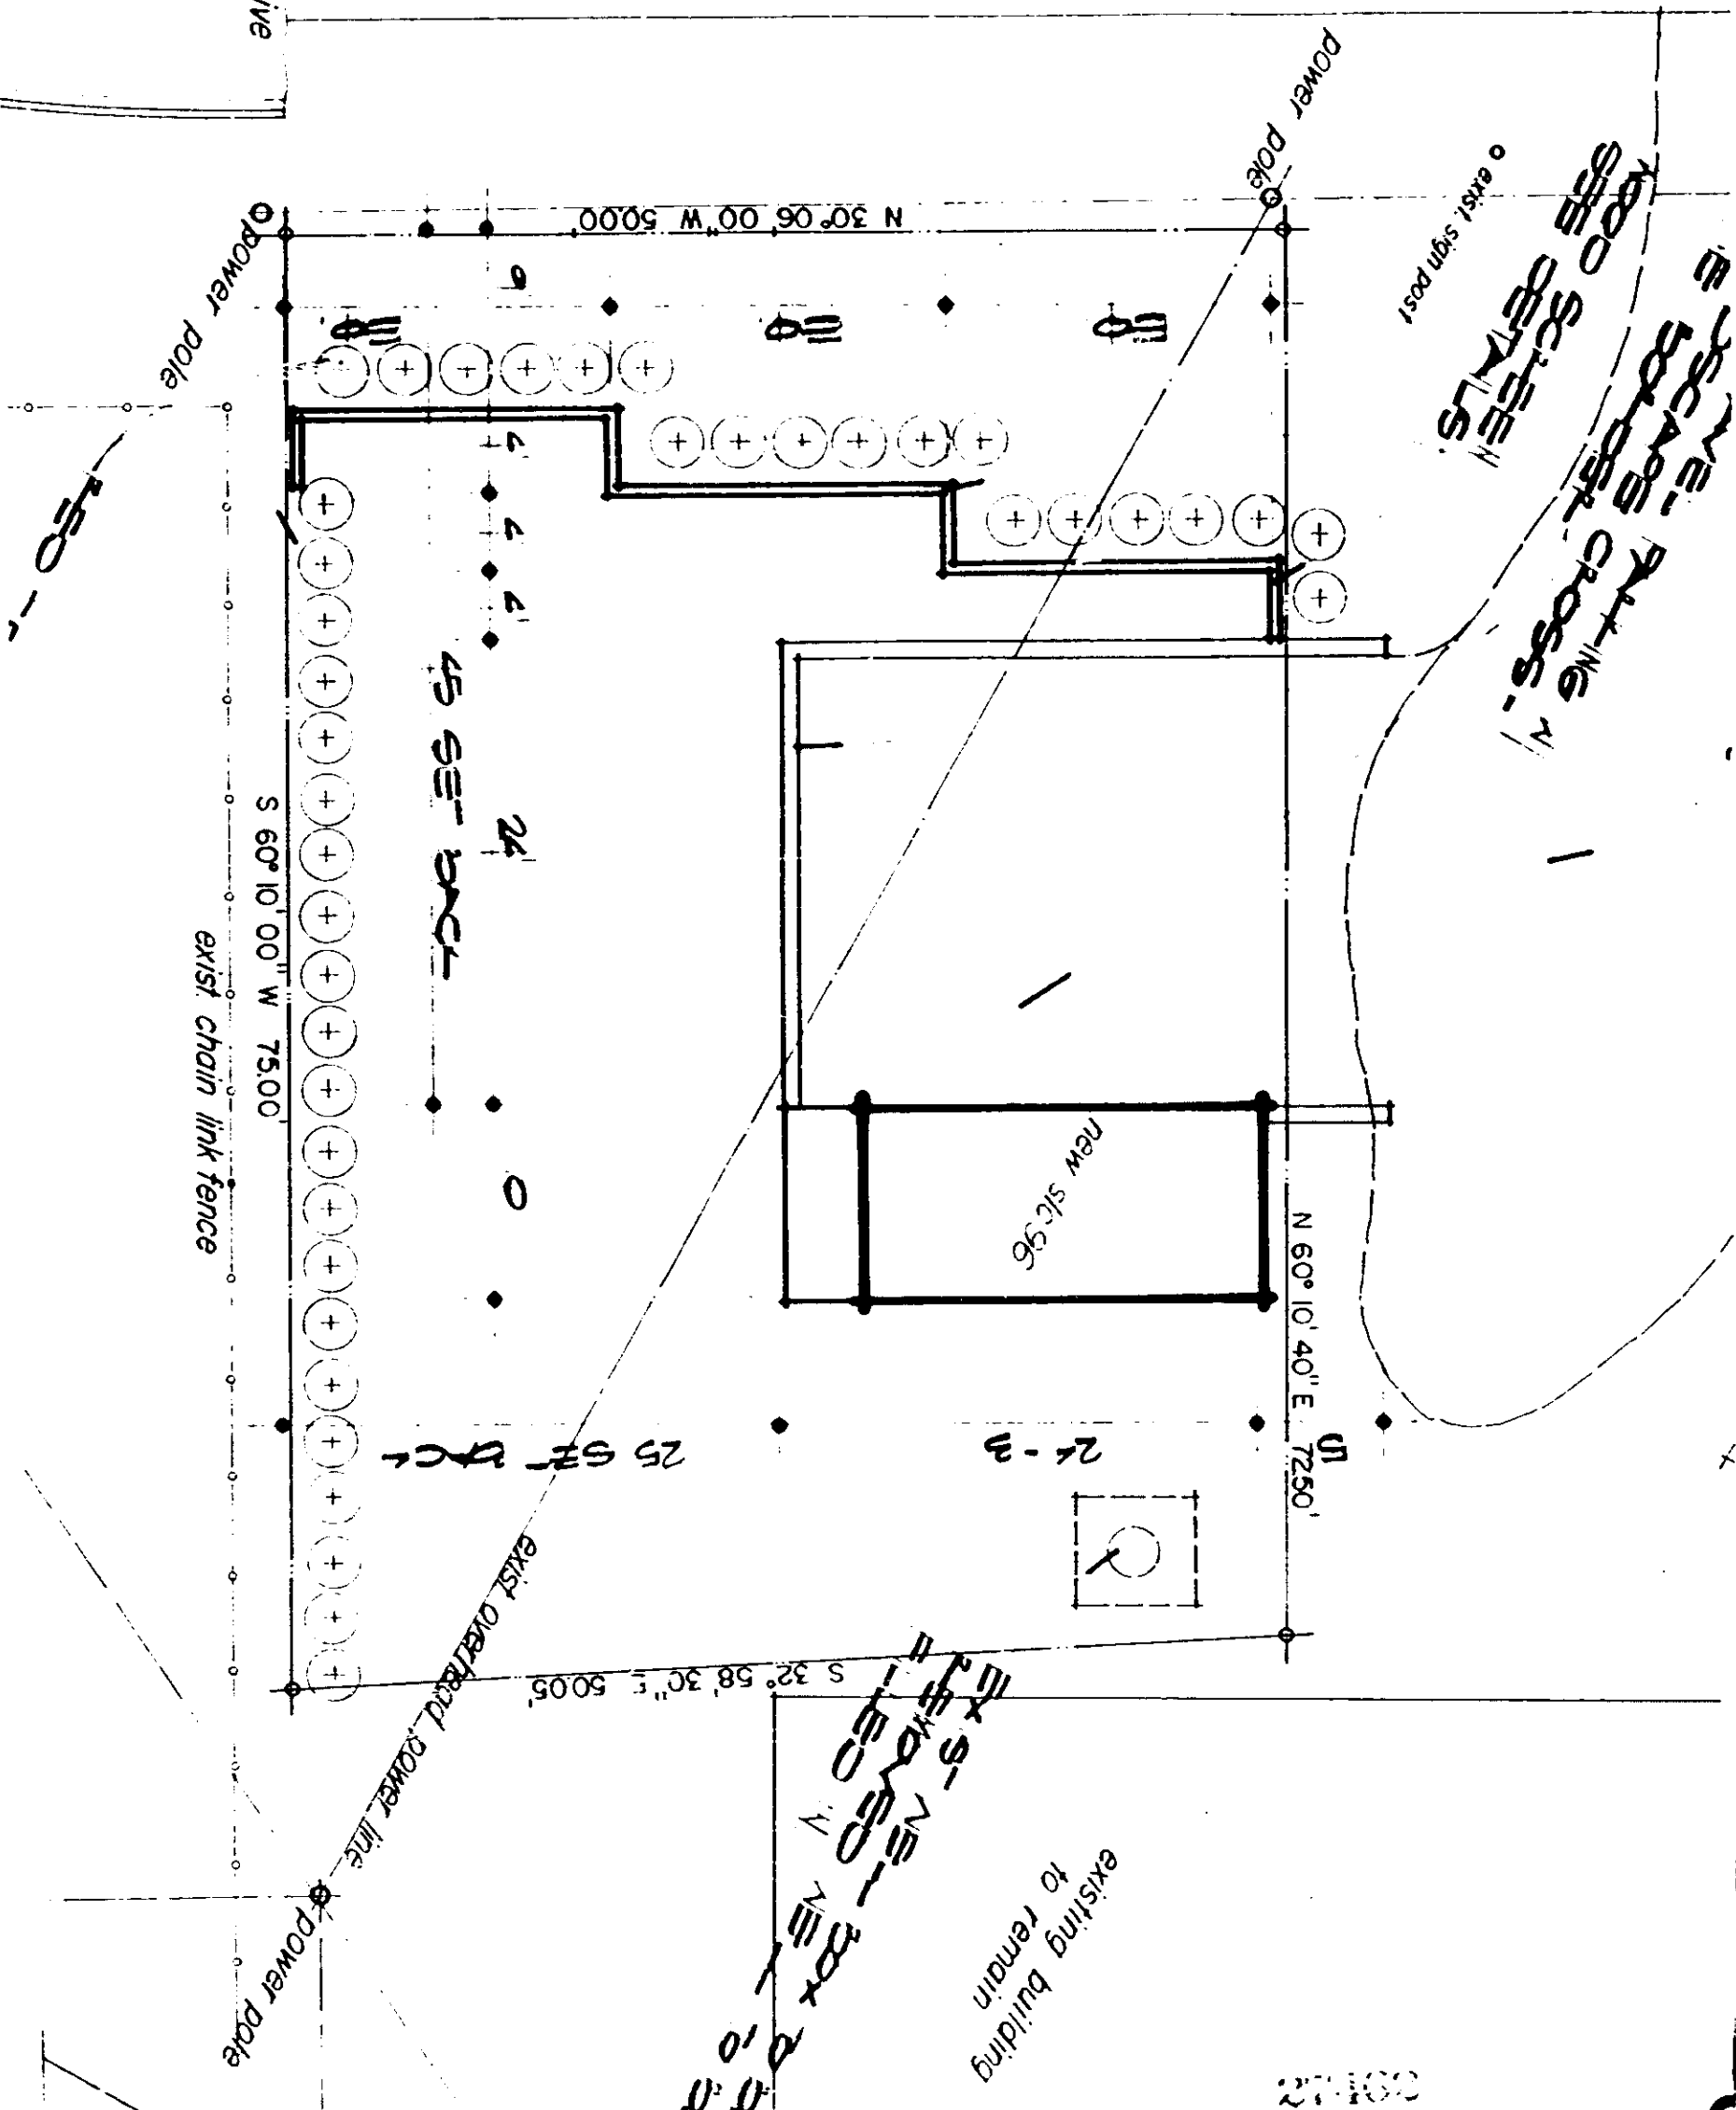

Recorded June 8, 1982 at 1:23 P/M

2220

2-AR 8264

27160